


PLEASE VERIFY ALL CLOUDED DIMENSIONS

PLEASE PROVIDE LOCATION AND LAYOUT FOR ANY MECHANICAL AND ELECTRICAL PENETRATIONS IN CMU WALLS

PLEASE VERIFY LOCATION OF ANY CONTROL JOINTS IN CMU IF REQUIRED.

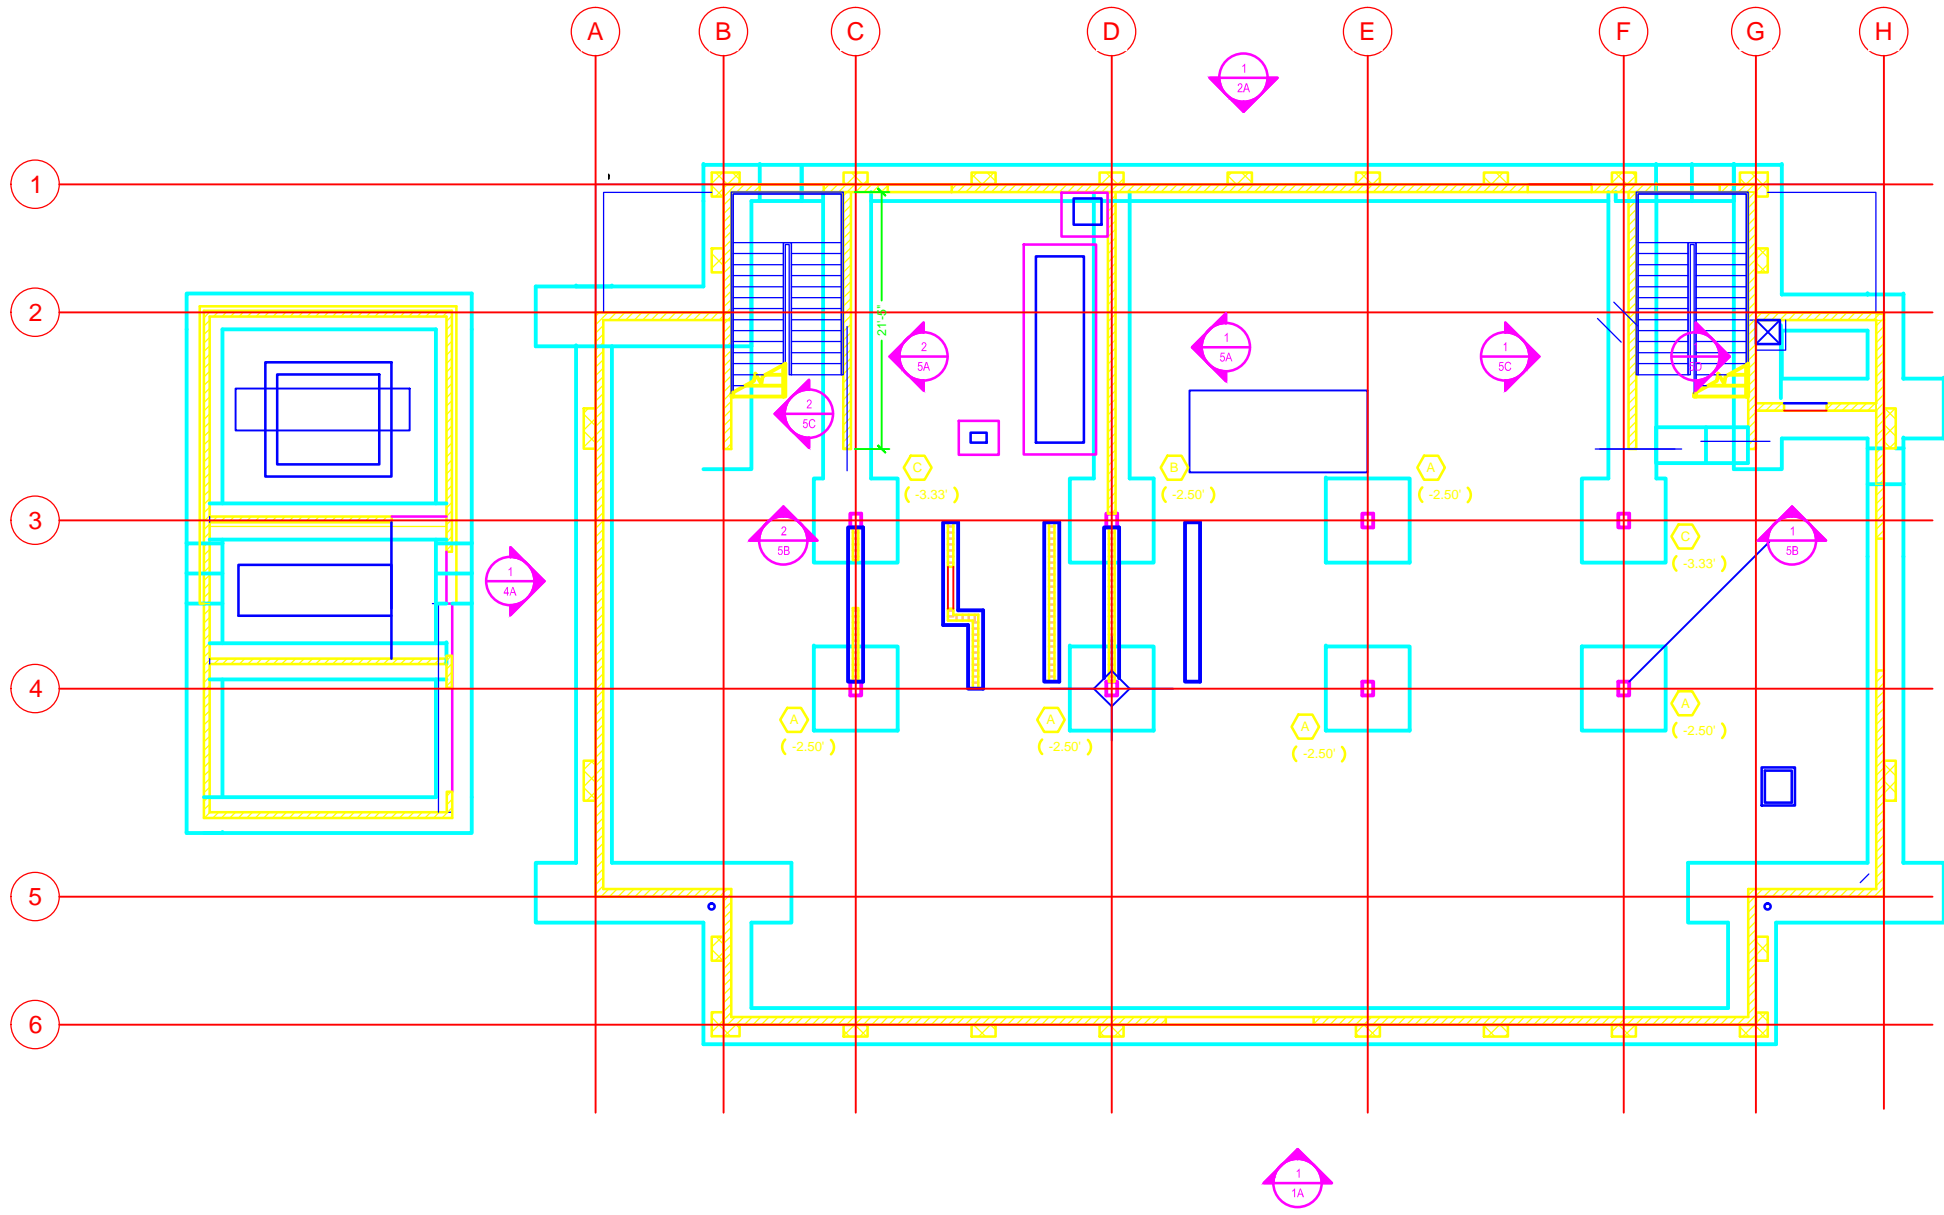


WWW.JANDSMASONRY.COM  
 425-888-0200 WA  
 503-581-7650 OR

## HALLIE FORD CMU LAYOUT PLANS

DATE: 6-01-10  
 SCALE: 1/8" = 1'-0"

GO

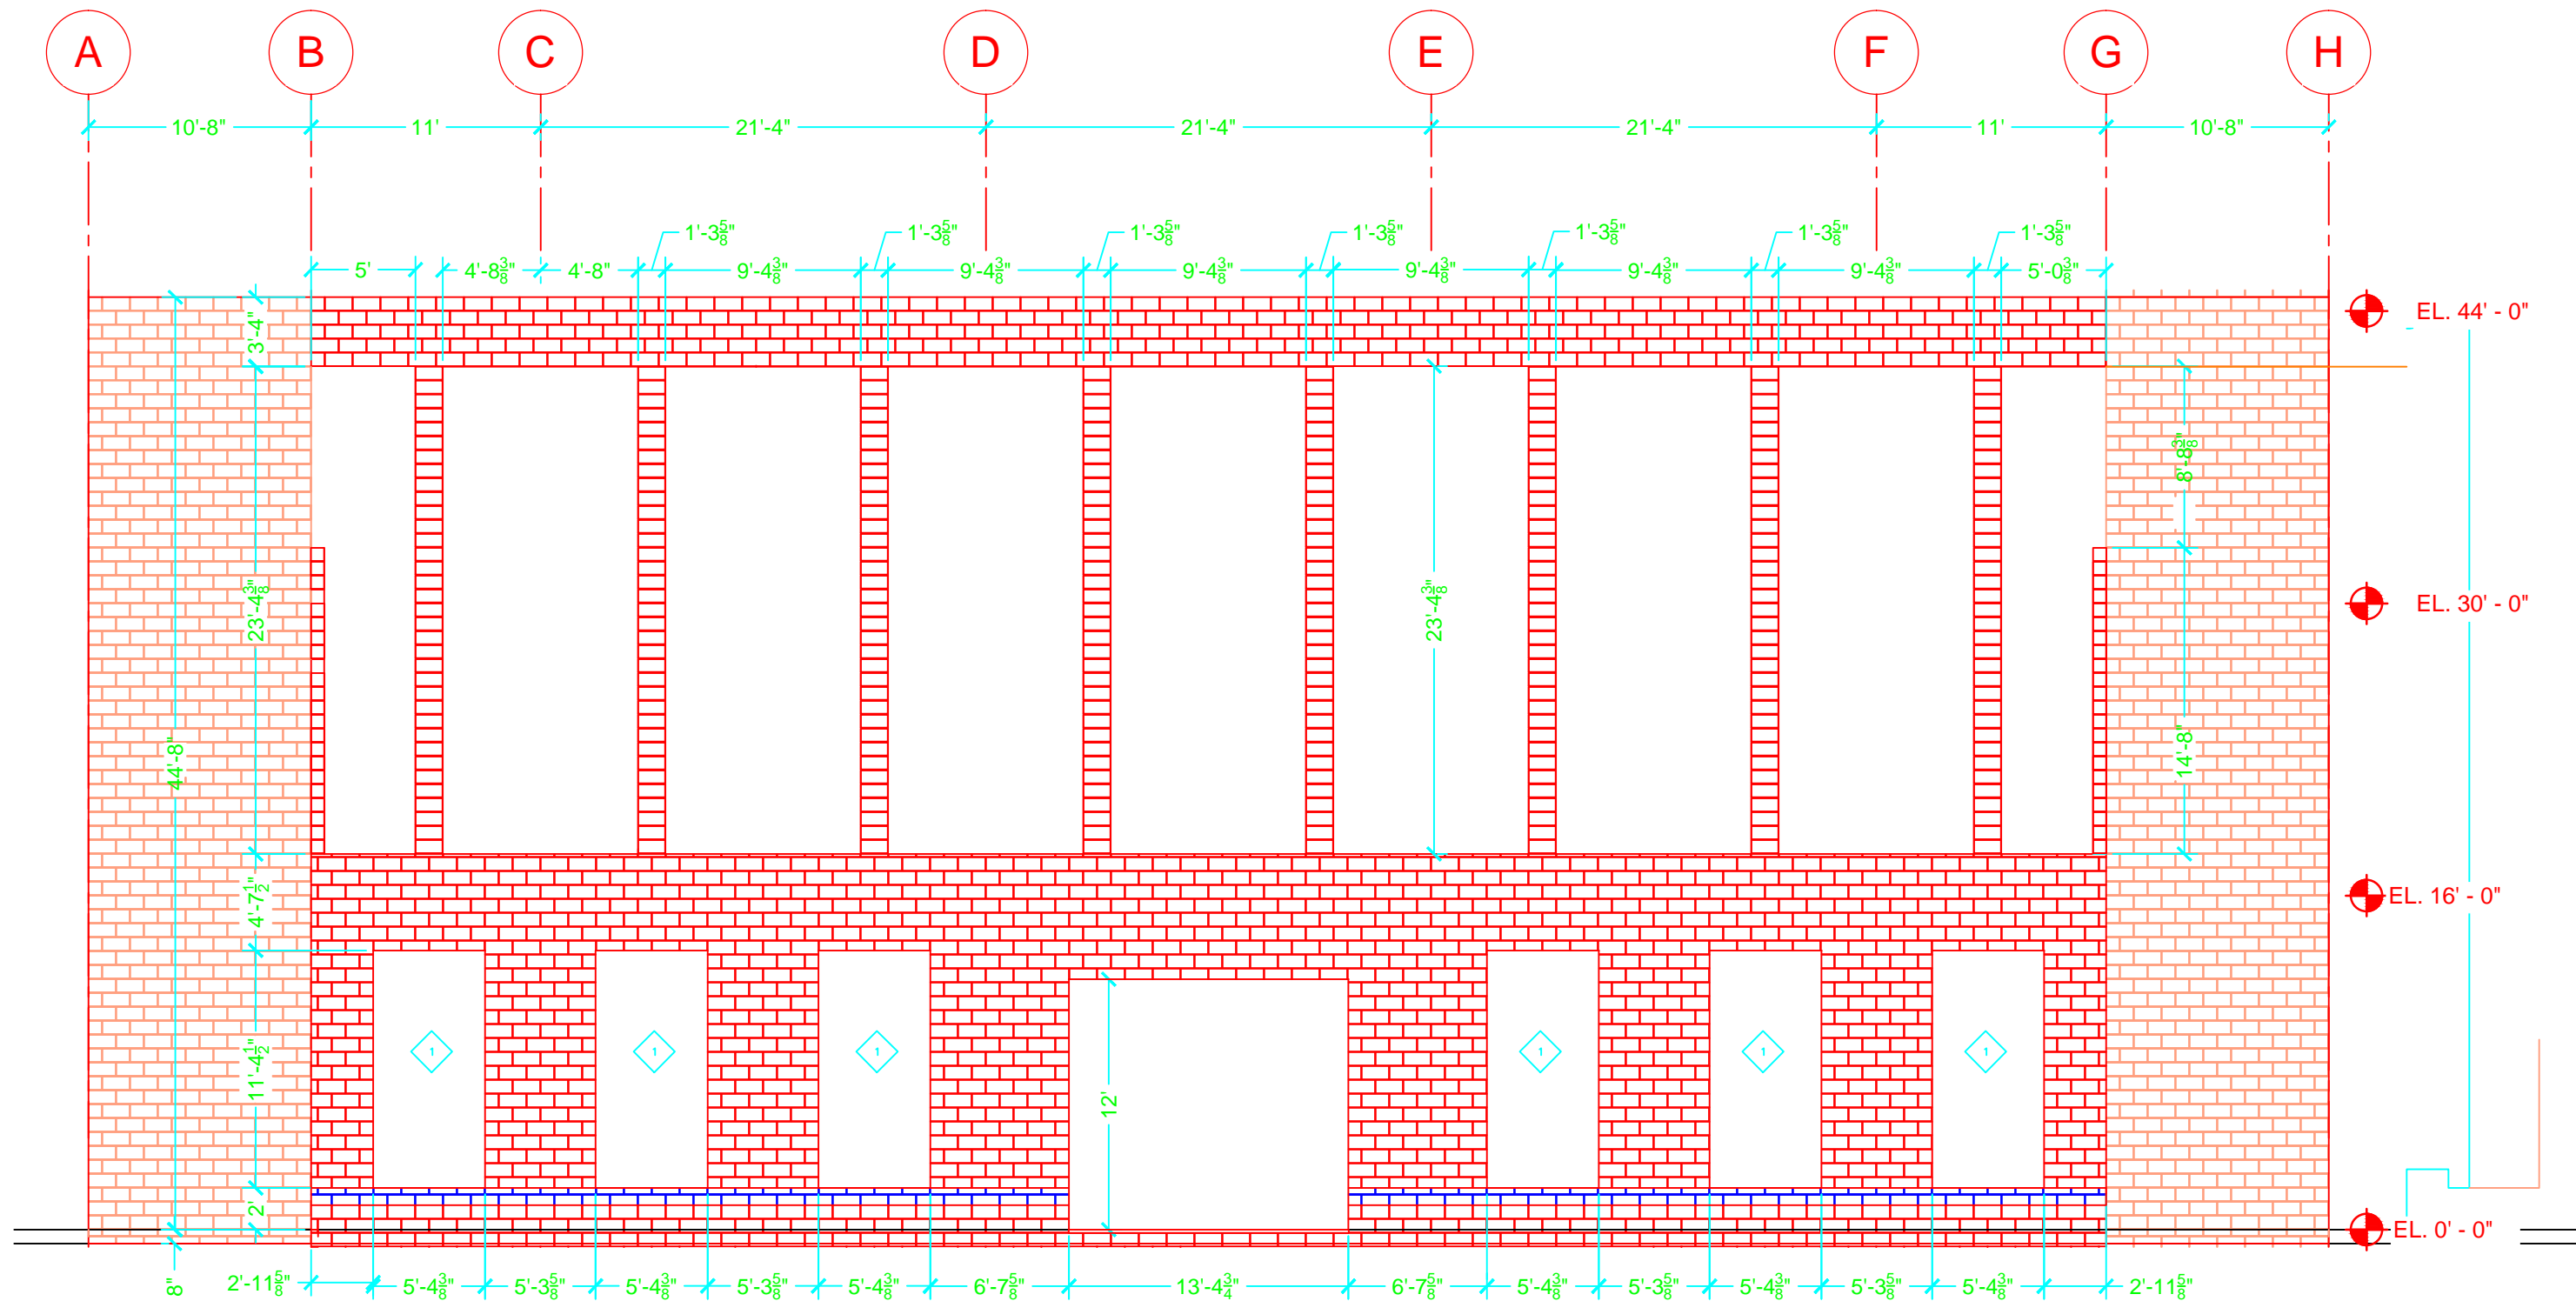

South Elevation 8" CMU Layout




WWW.JANDSMASONRY.COM  
 425-888-0200 WA  
 503-581-7650 OR

**SOUTH ELEVATION  
 8" CMU DIMENSIONS**

DATE: 6-01-10

SCALE: 1/8" = 1'-0"

1A

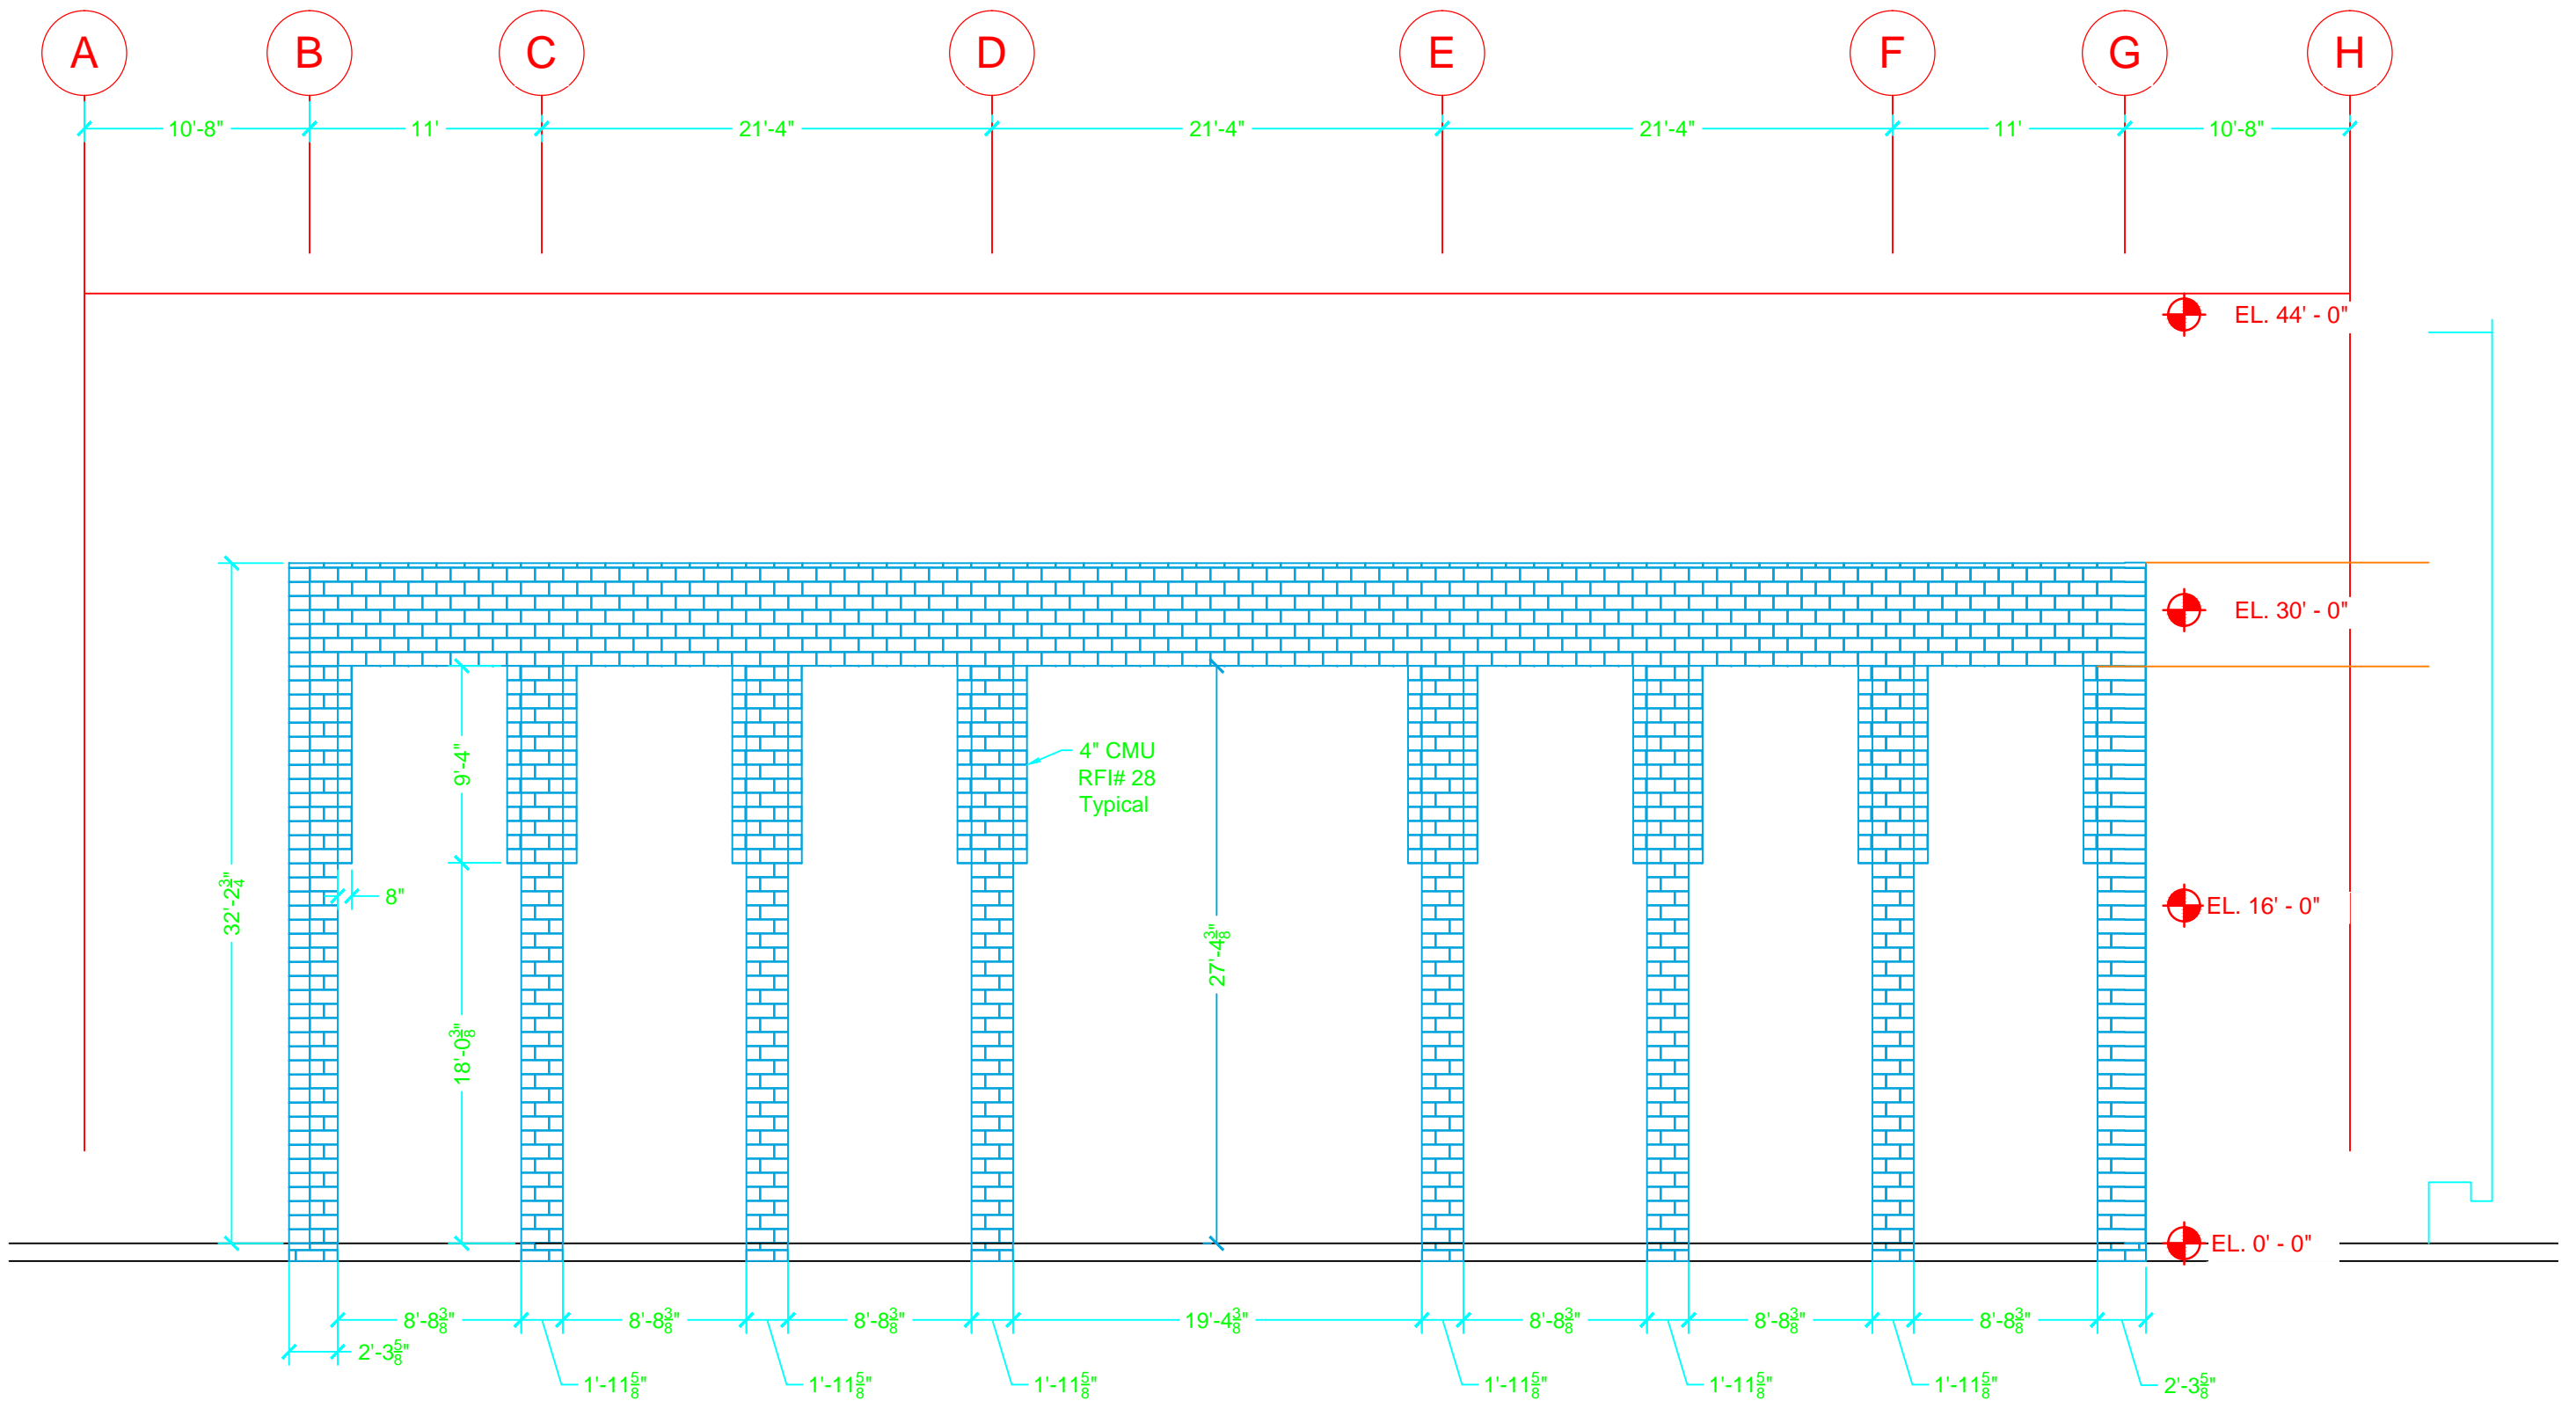

South Elevation 12" CMU Layout




WWW.JANDSMASONRY.COM  
 425-888-0200 WA  
 503-581-7650 OR

**SOUTH ELEVATION  
 8" CMU DIMENSIONS**

DATE: 6-01-10

SCALE: 1/8" = 1'-0"

**1B**

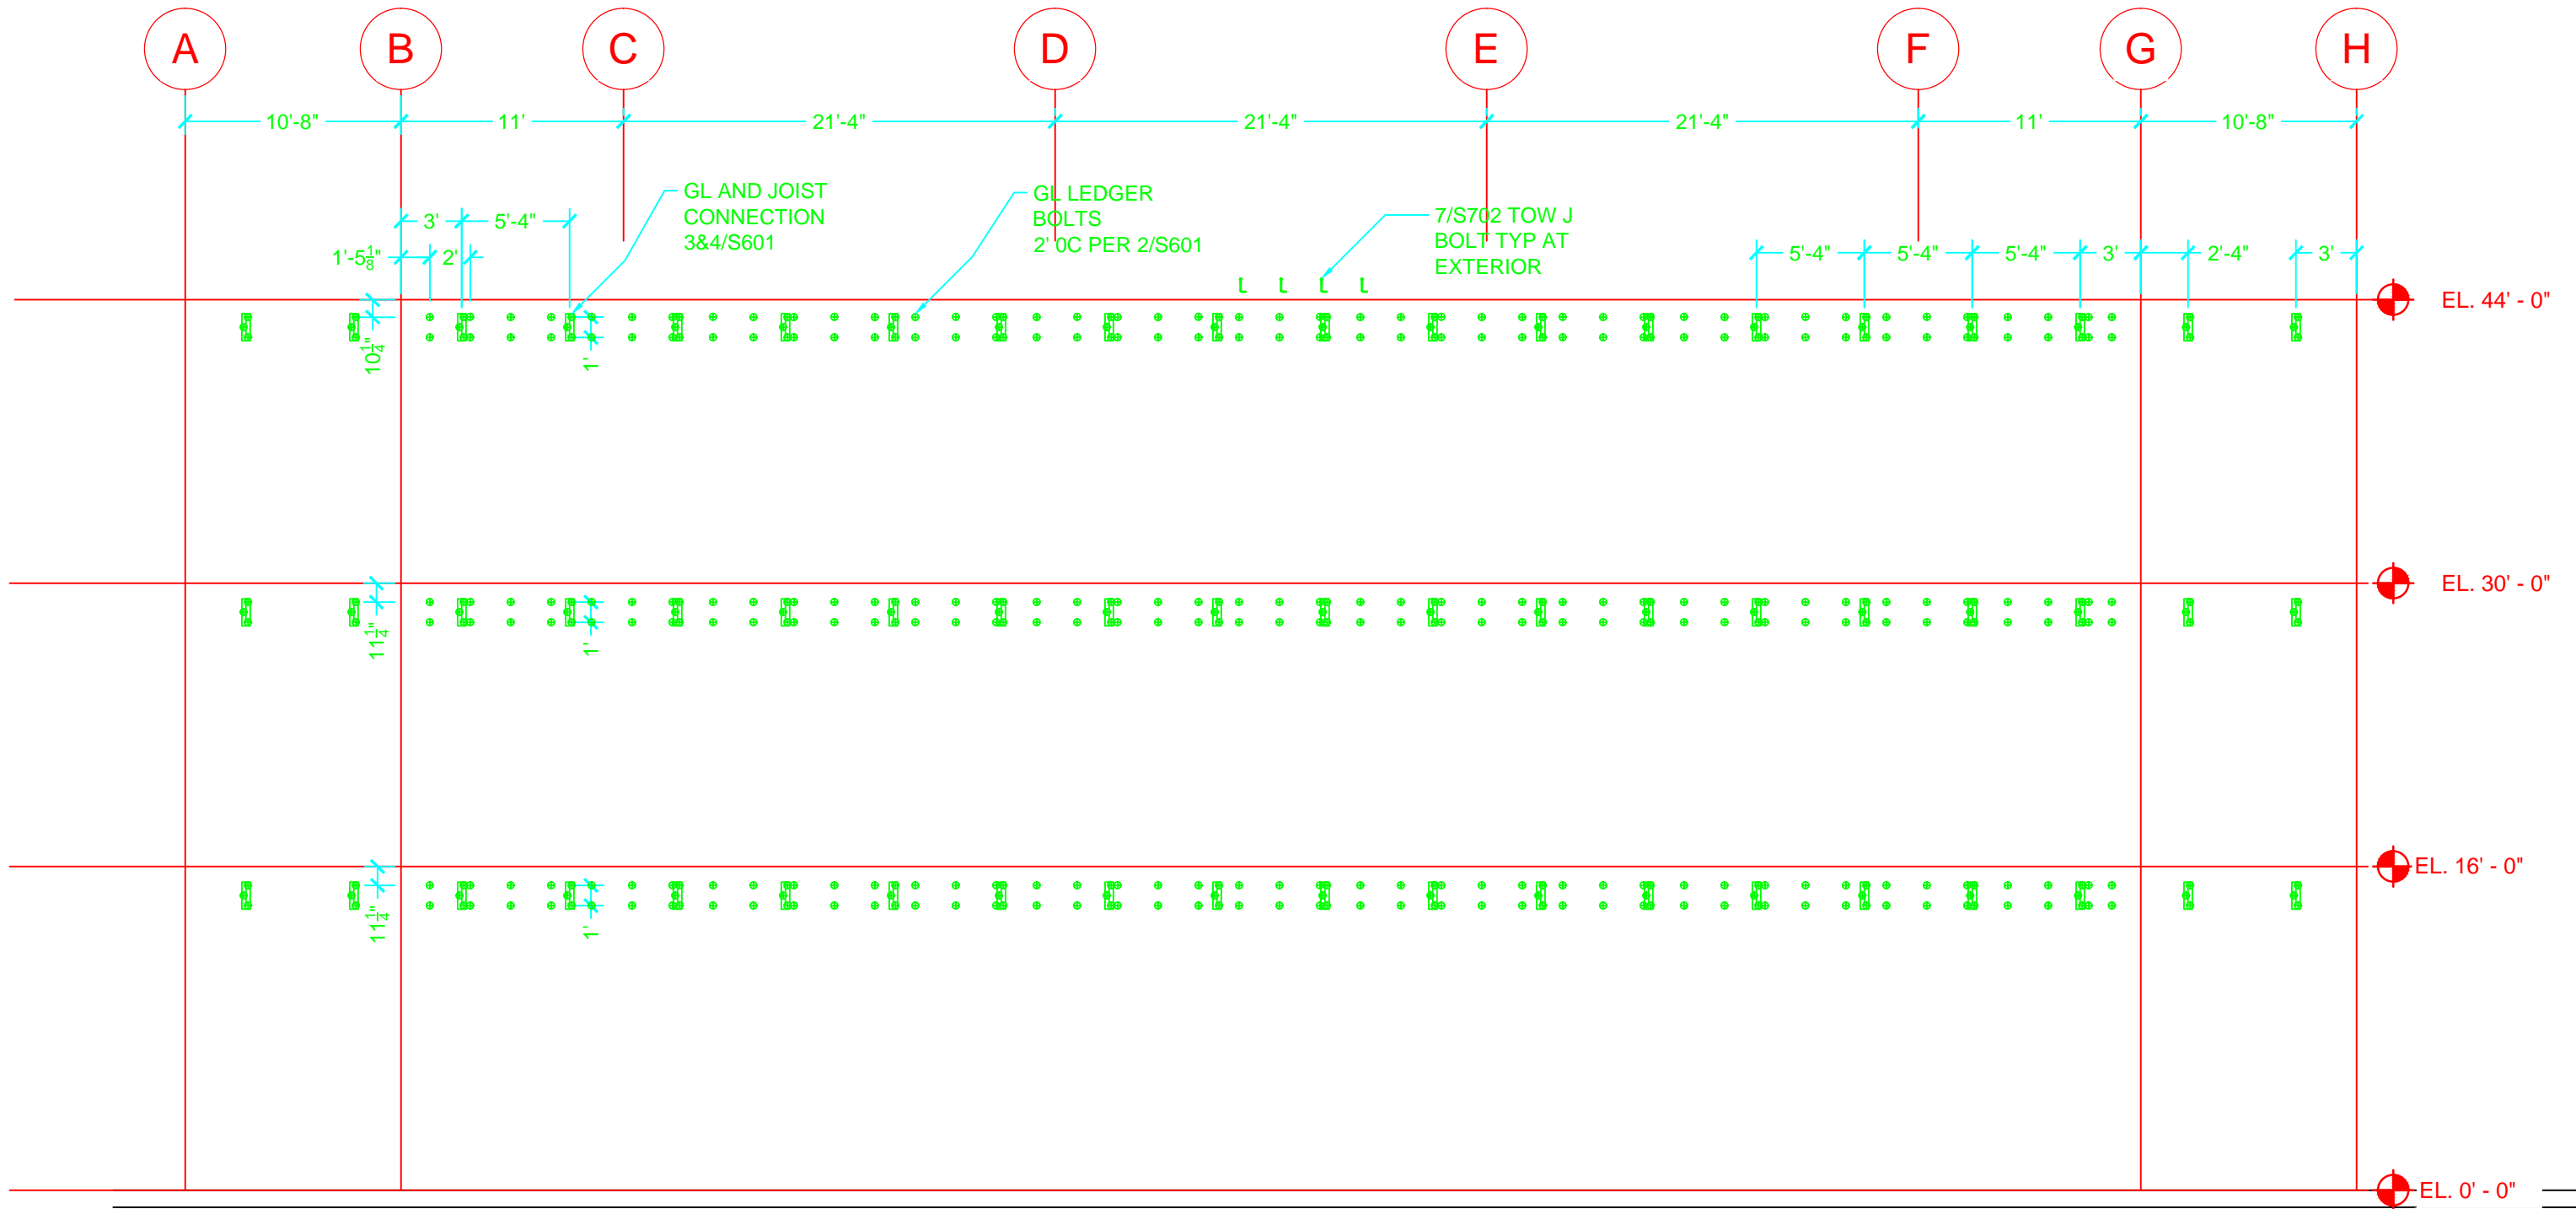


WWW.JANDSMASONRY.COM  
 425-888-0200 WA  
 503-581-7650 OR

**SOUTH ELEVATION  
 EMBED LAYOUT**

DATE: 6-01-10  
 SCALE: 1/8" = 1'-0"

**1C**

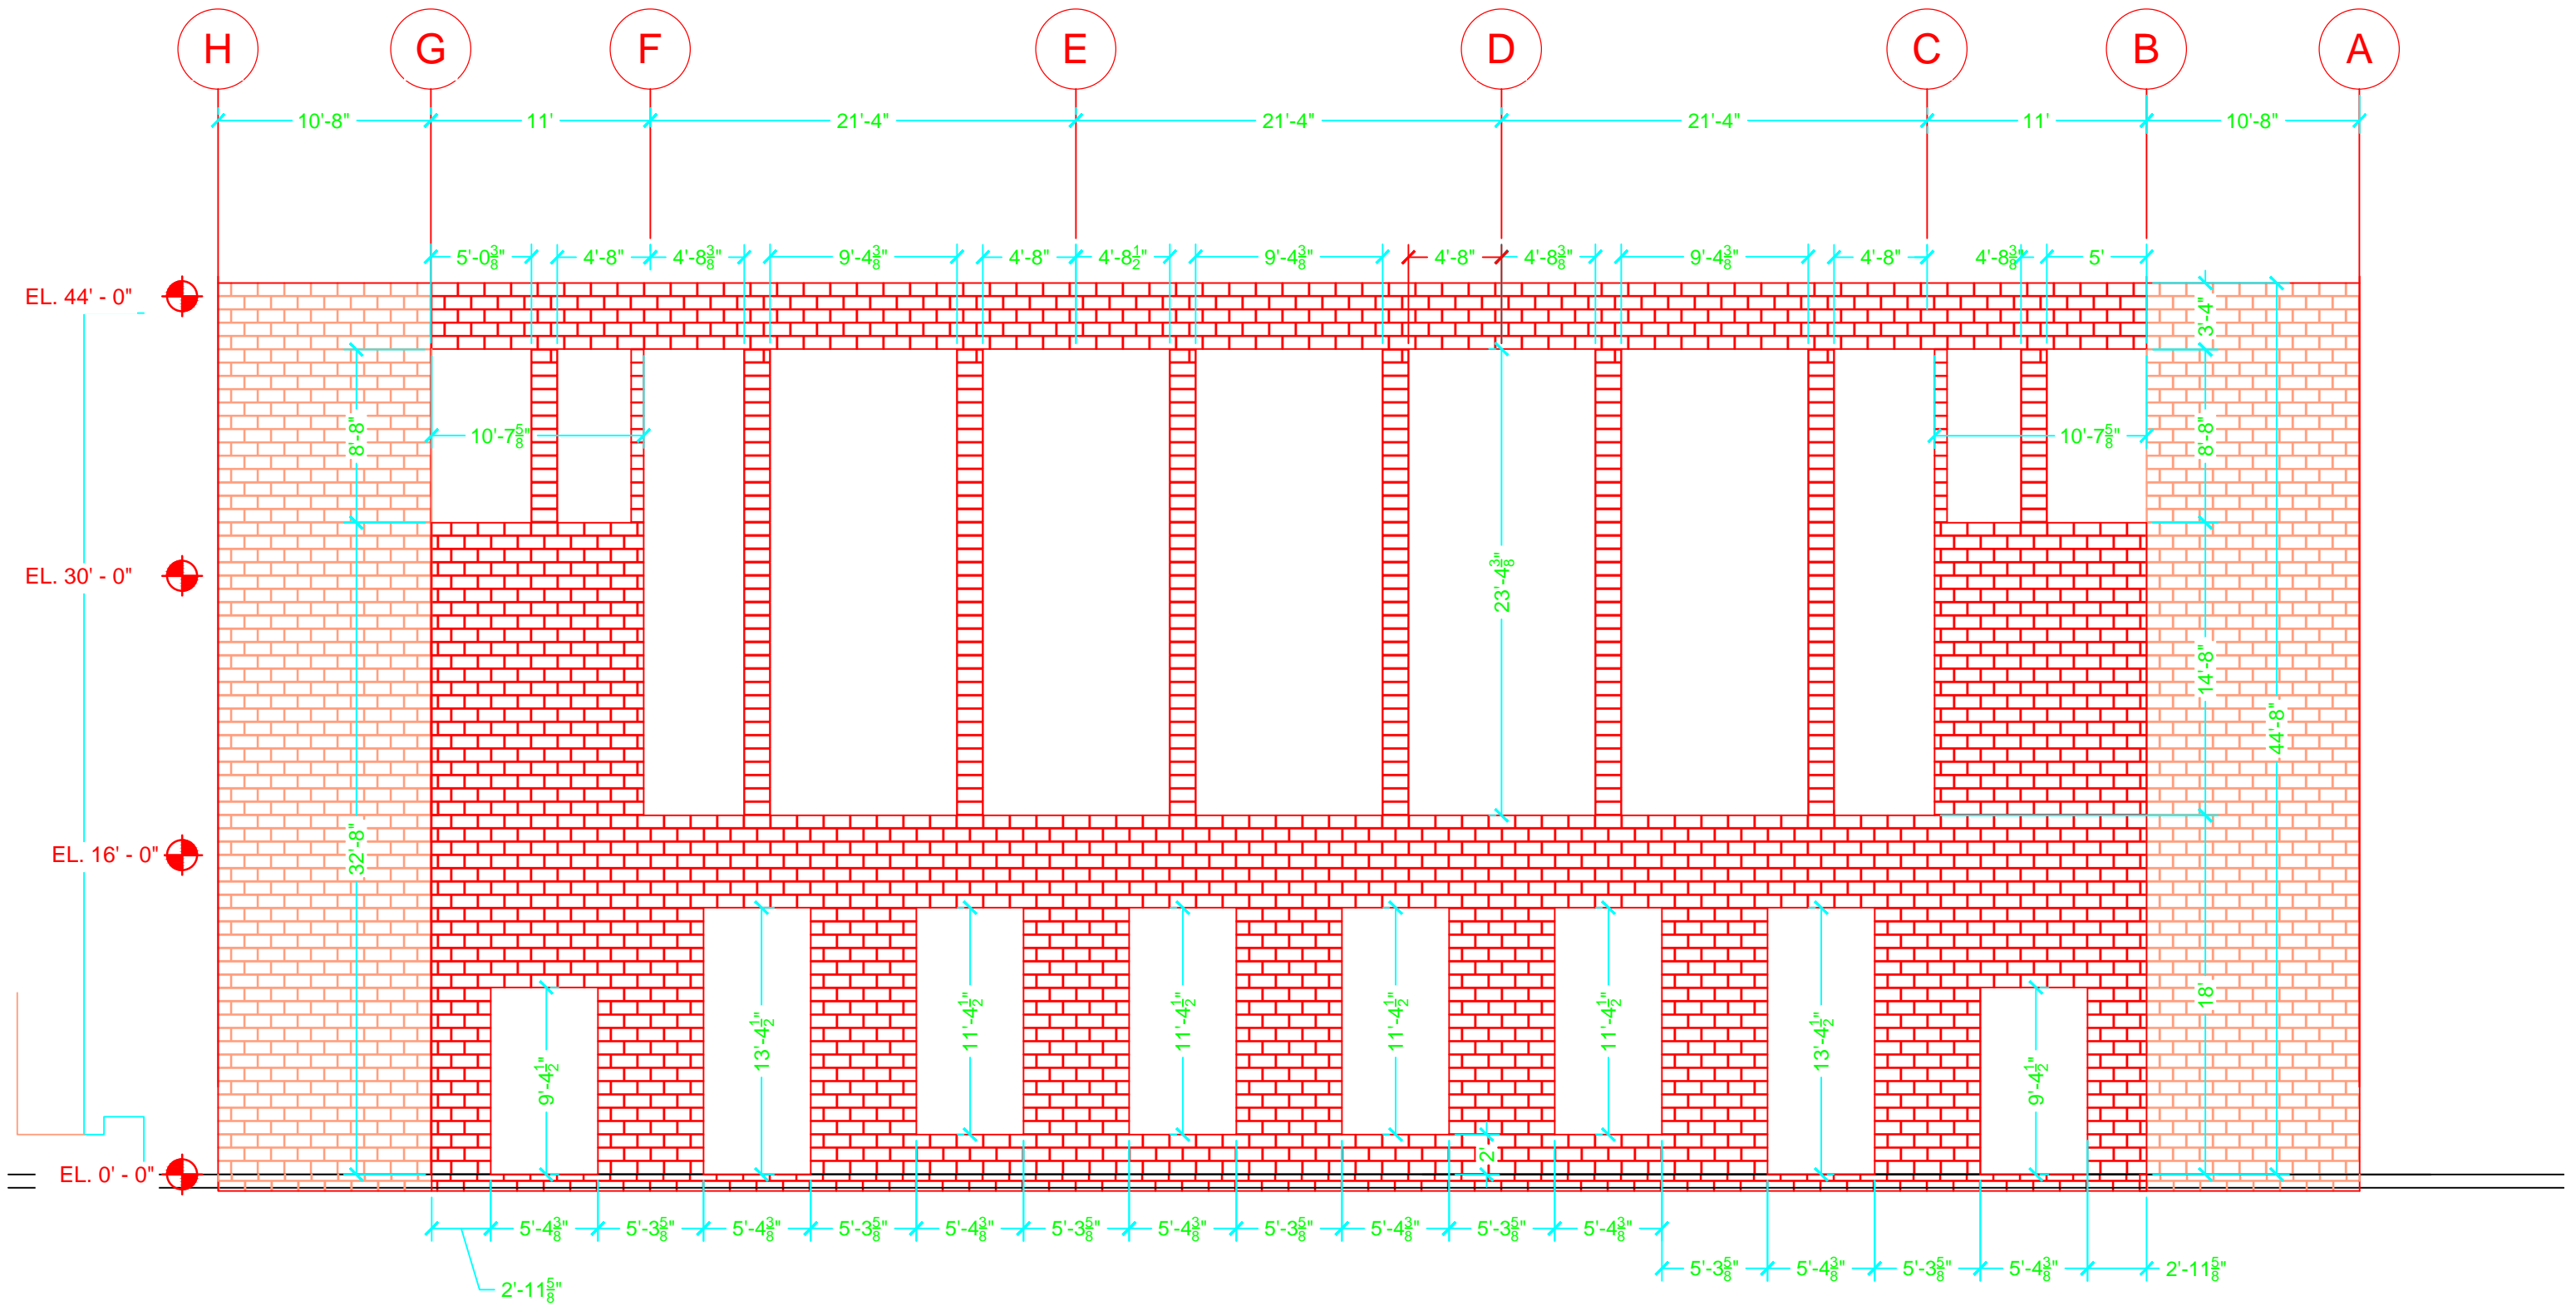


North Elevation 8" CMU Layout



WWW.JANDSMASONRY.COM  
 425-888-0200 WA  
 503-581-7650 OR

**NORTH ELEVATION  
 8" CMU DIMENSIONS**

DATE: 6-01-10  
 SCALE: 1/8" = 1'-0"

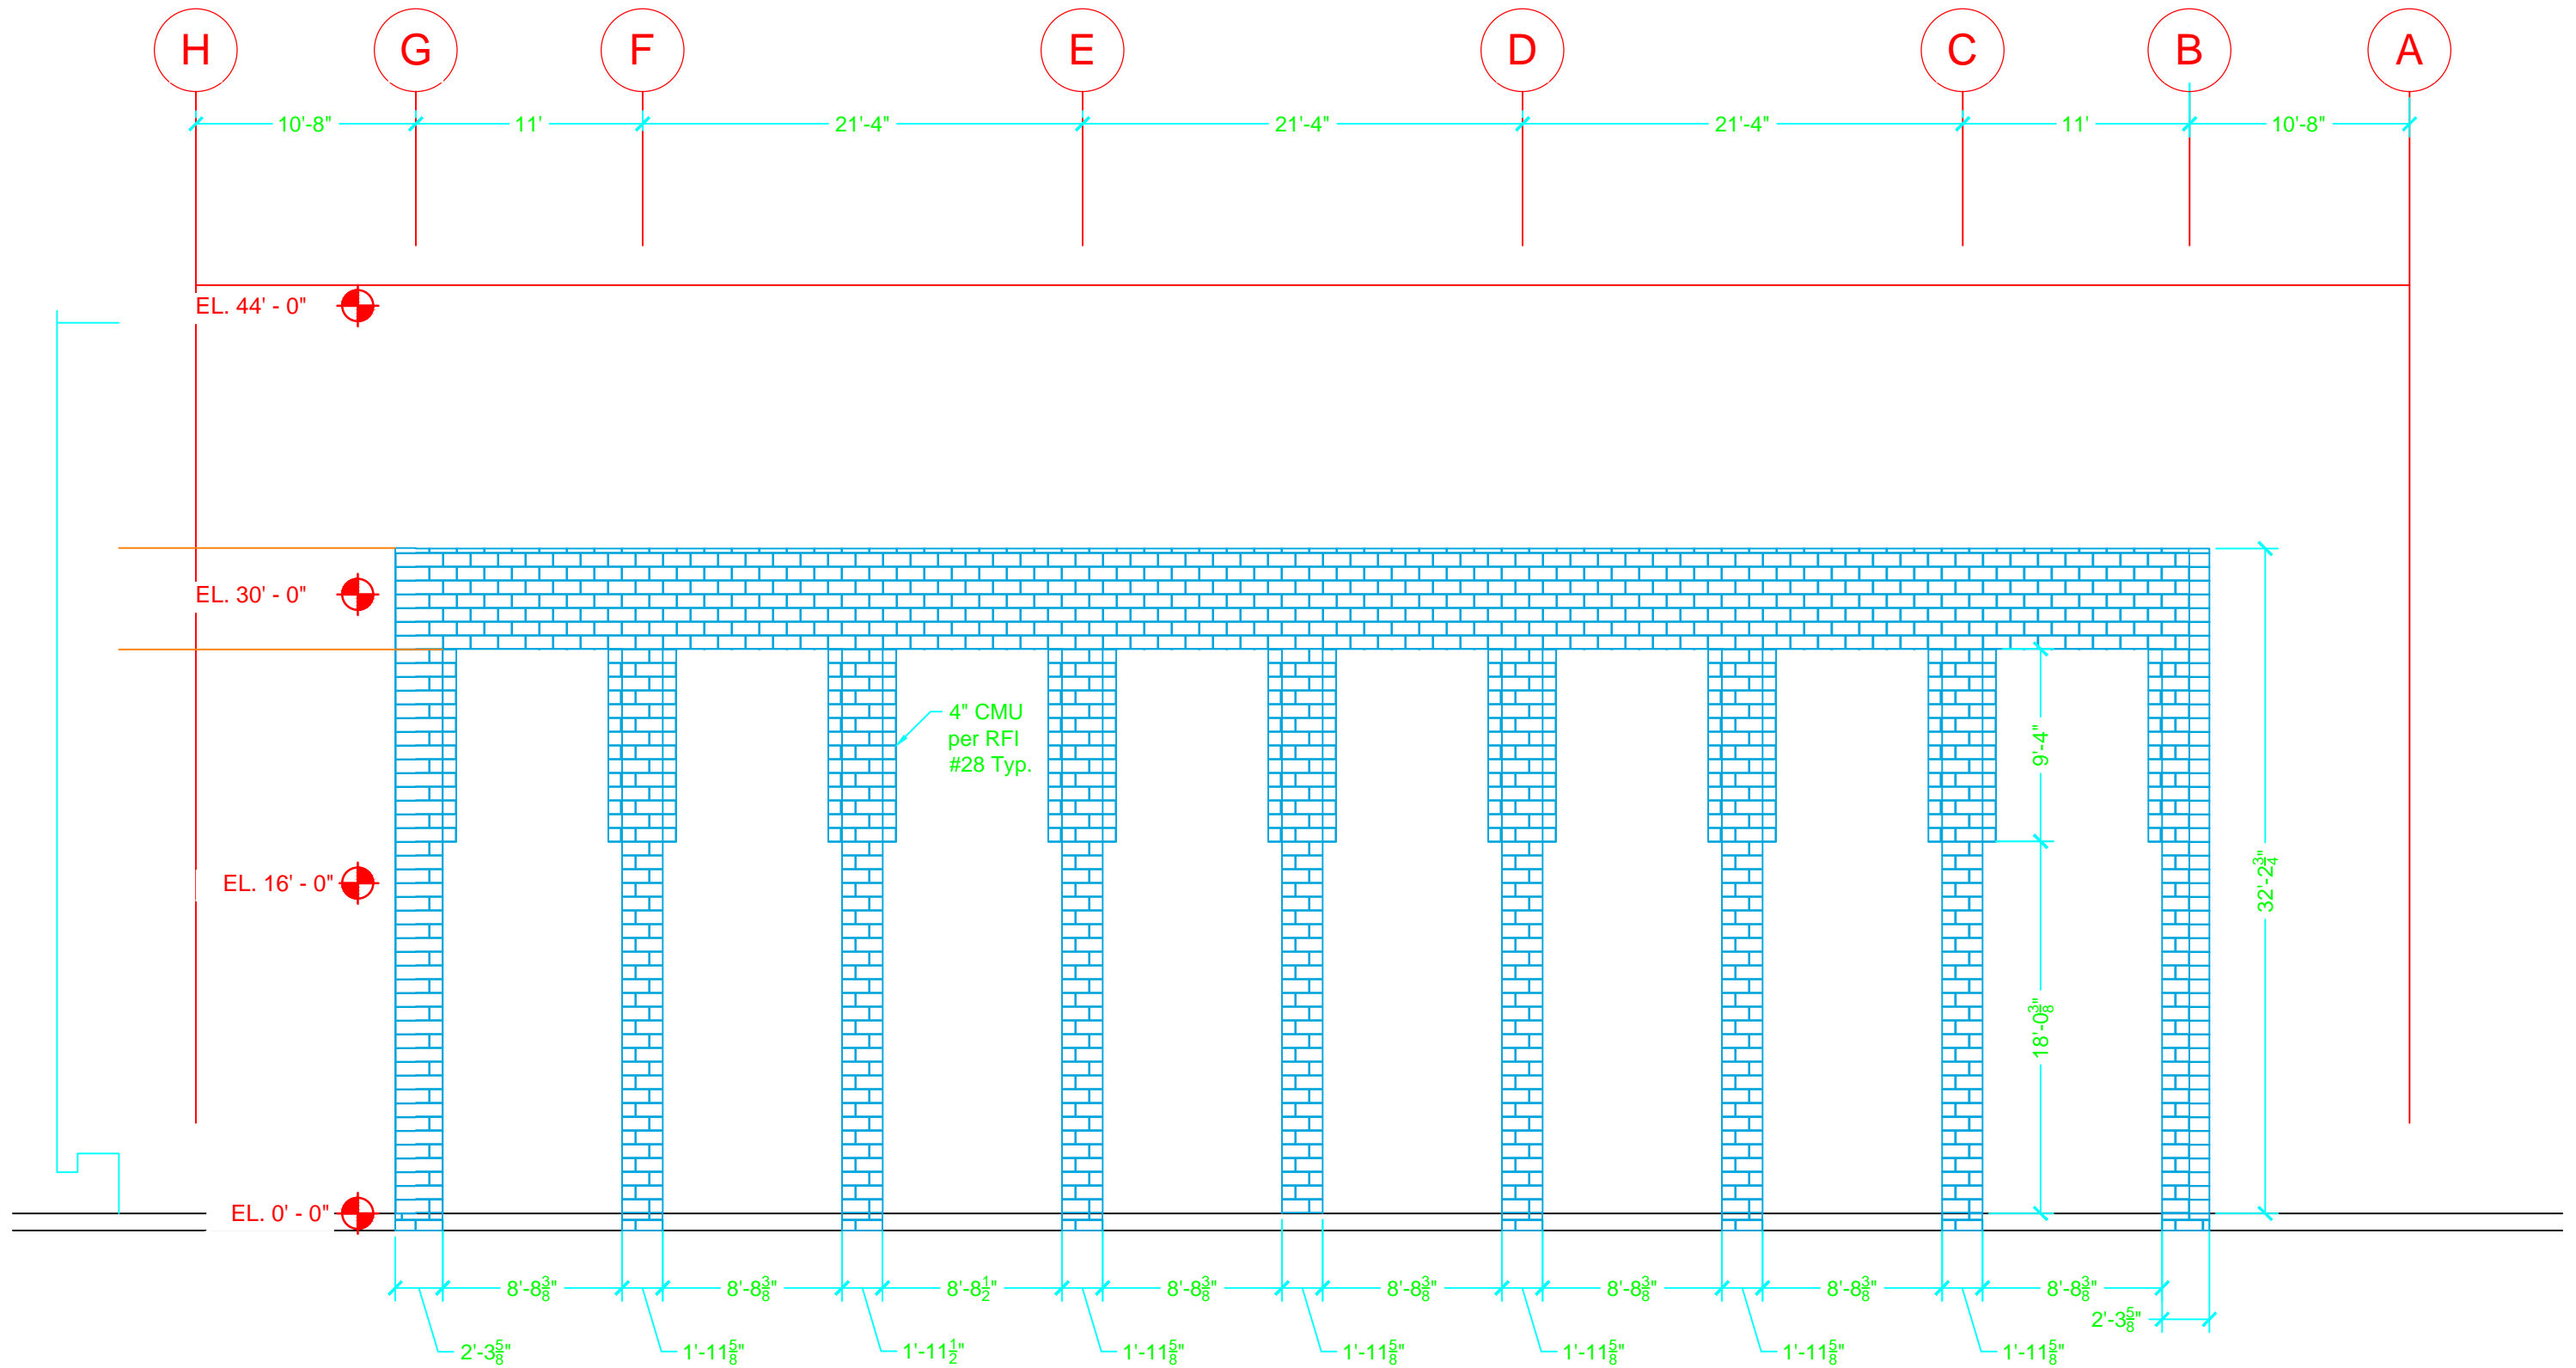

North Elevation 12" CMU Layout




WWW.JANDSMASONRY.COM  
 425-888-0200 WA  
 503-581-7650 OR

## NORTH ELEVATION 12" CMU DIMENSIONS

DATE: 6-01-10  
 SCALE: 1/8" = 1'-0"

2B

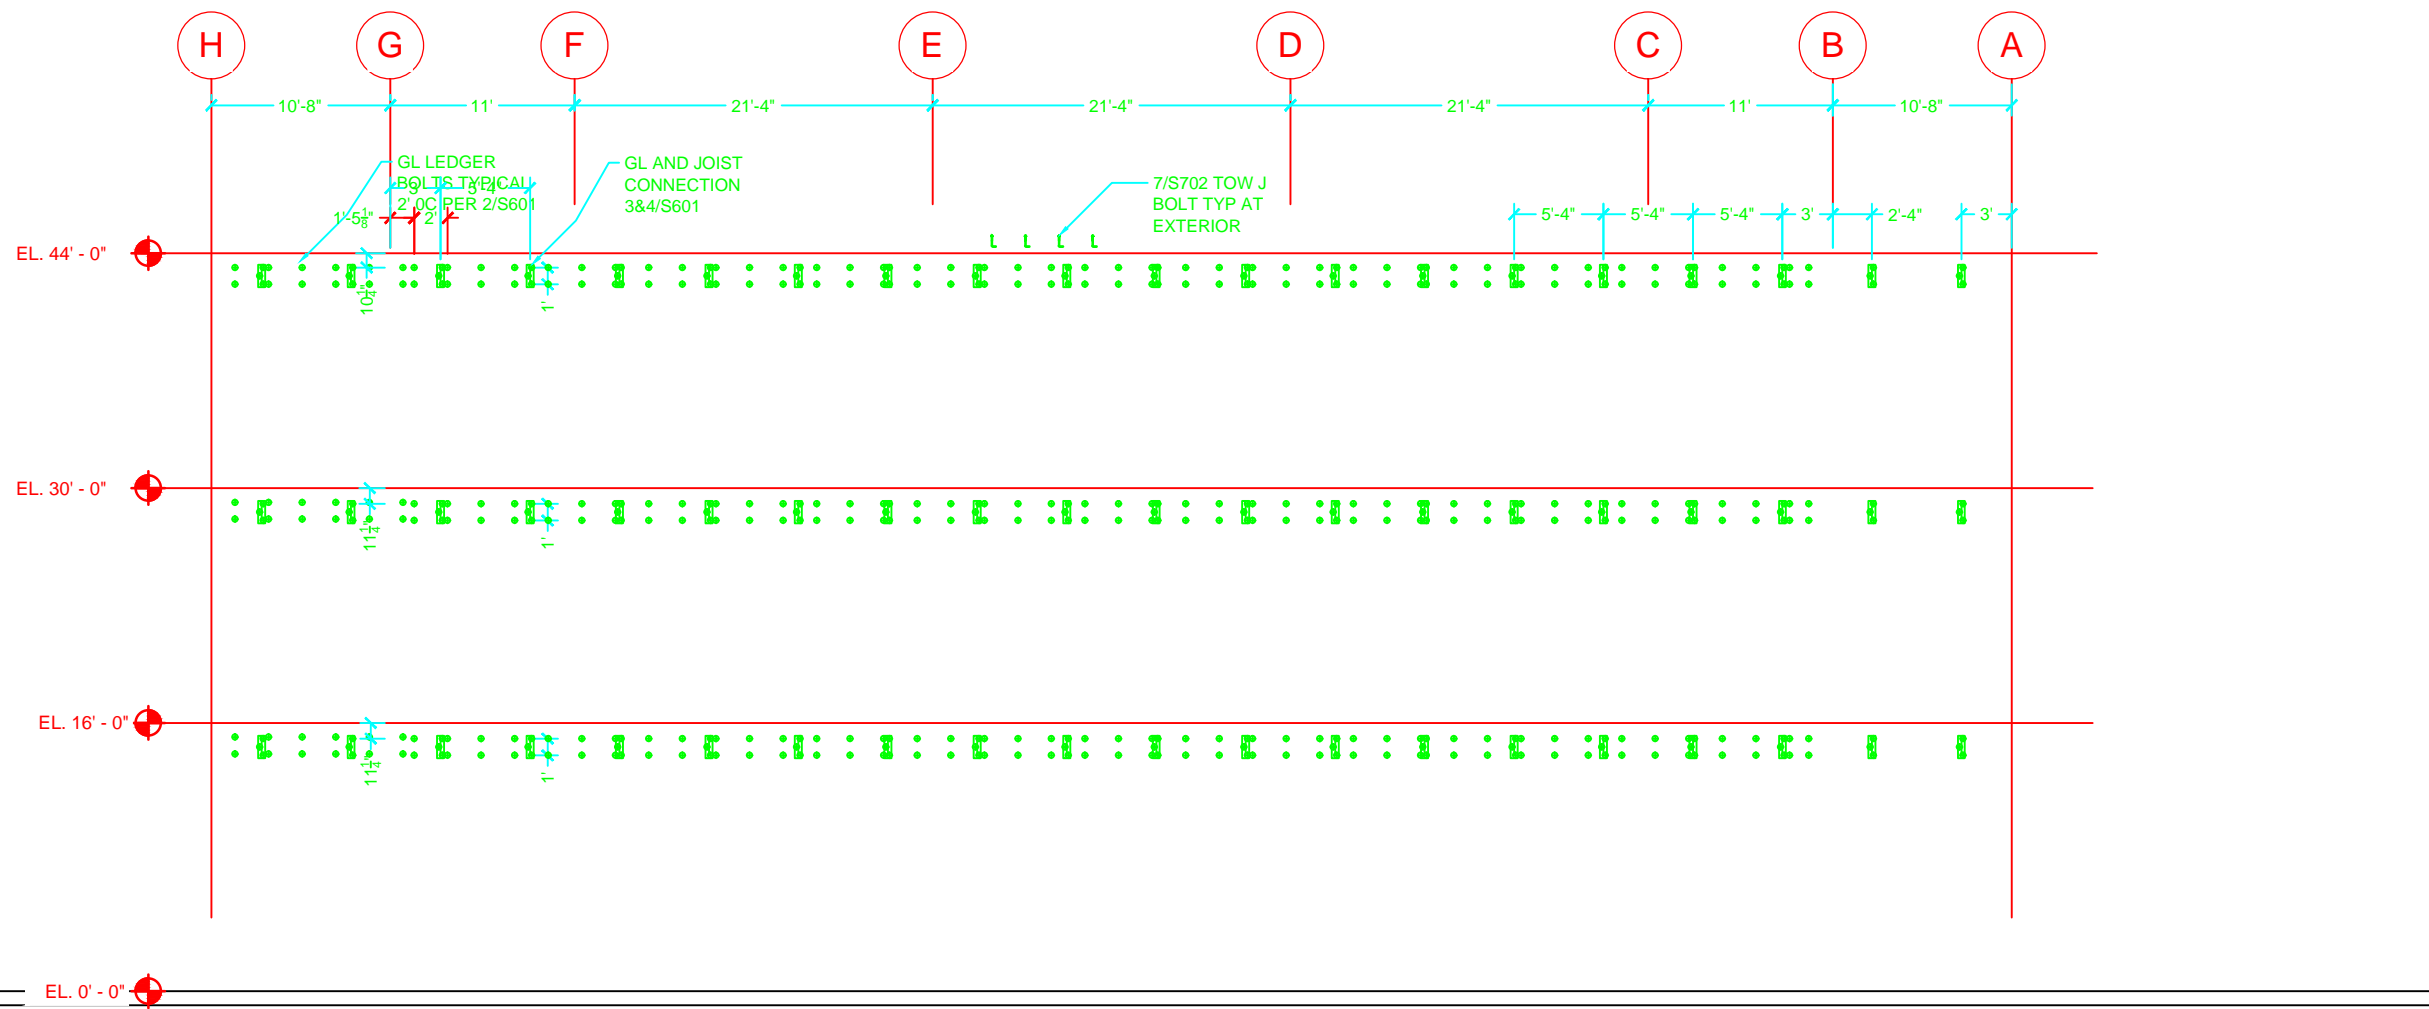


WWW.JANDSMASONRY.COM  
425-888-0200 WA  
503-581-7650 OR

**NORTH ELEVATION  
EMBED LAYOUT**

DATE: 6-01-10  
SCALE: 1/8" = 1'-0"

**2C**

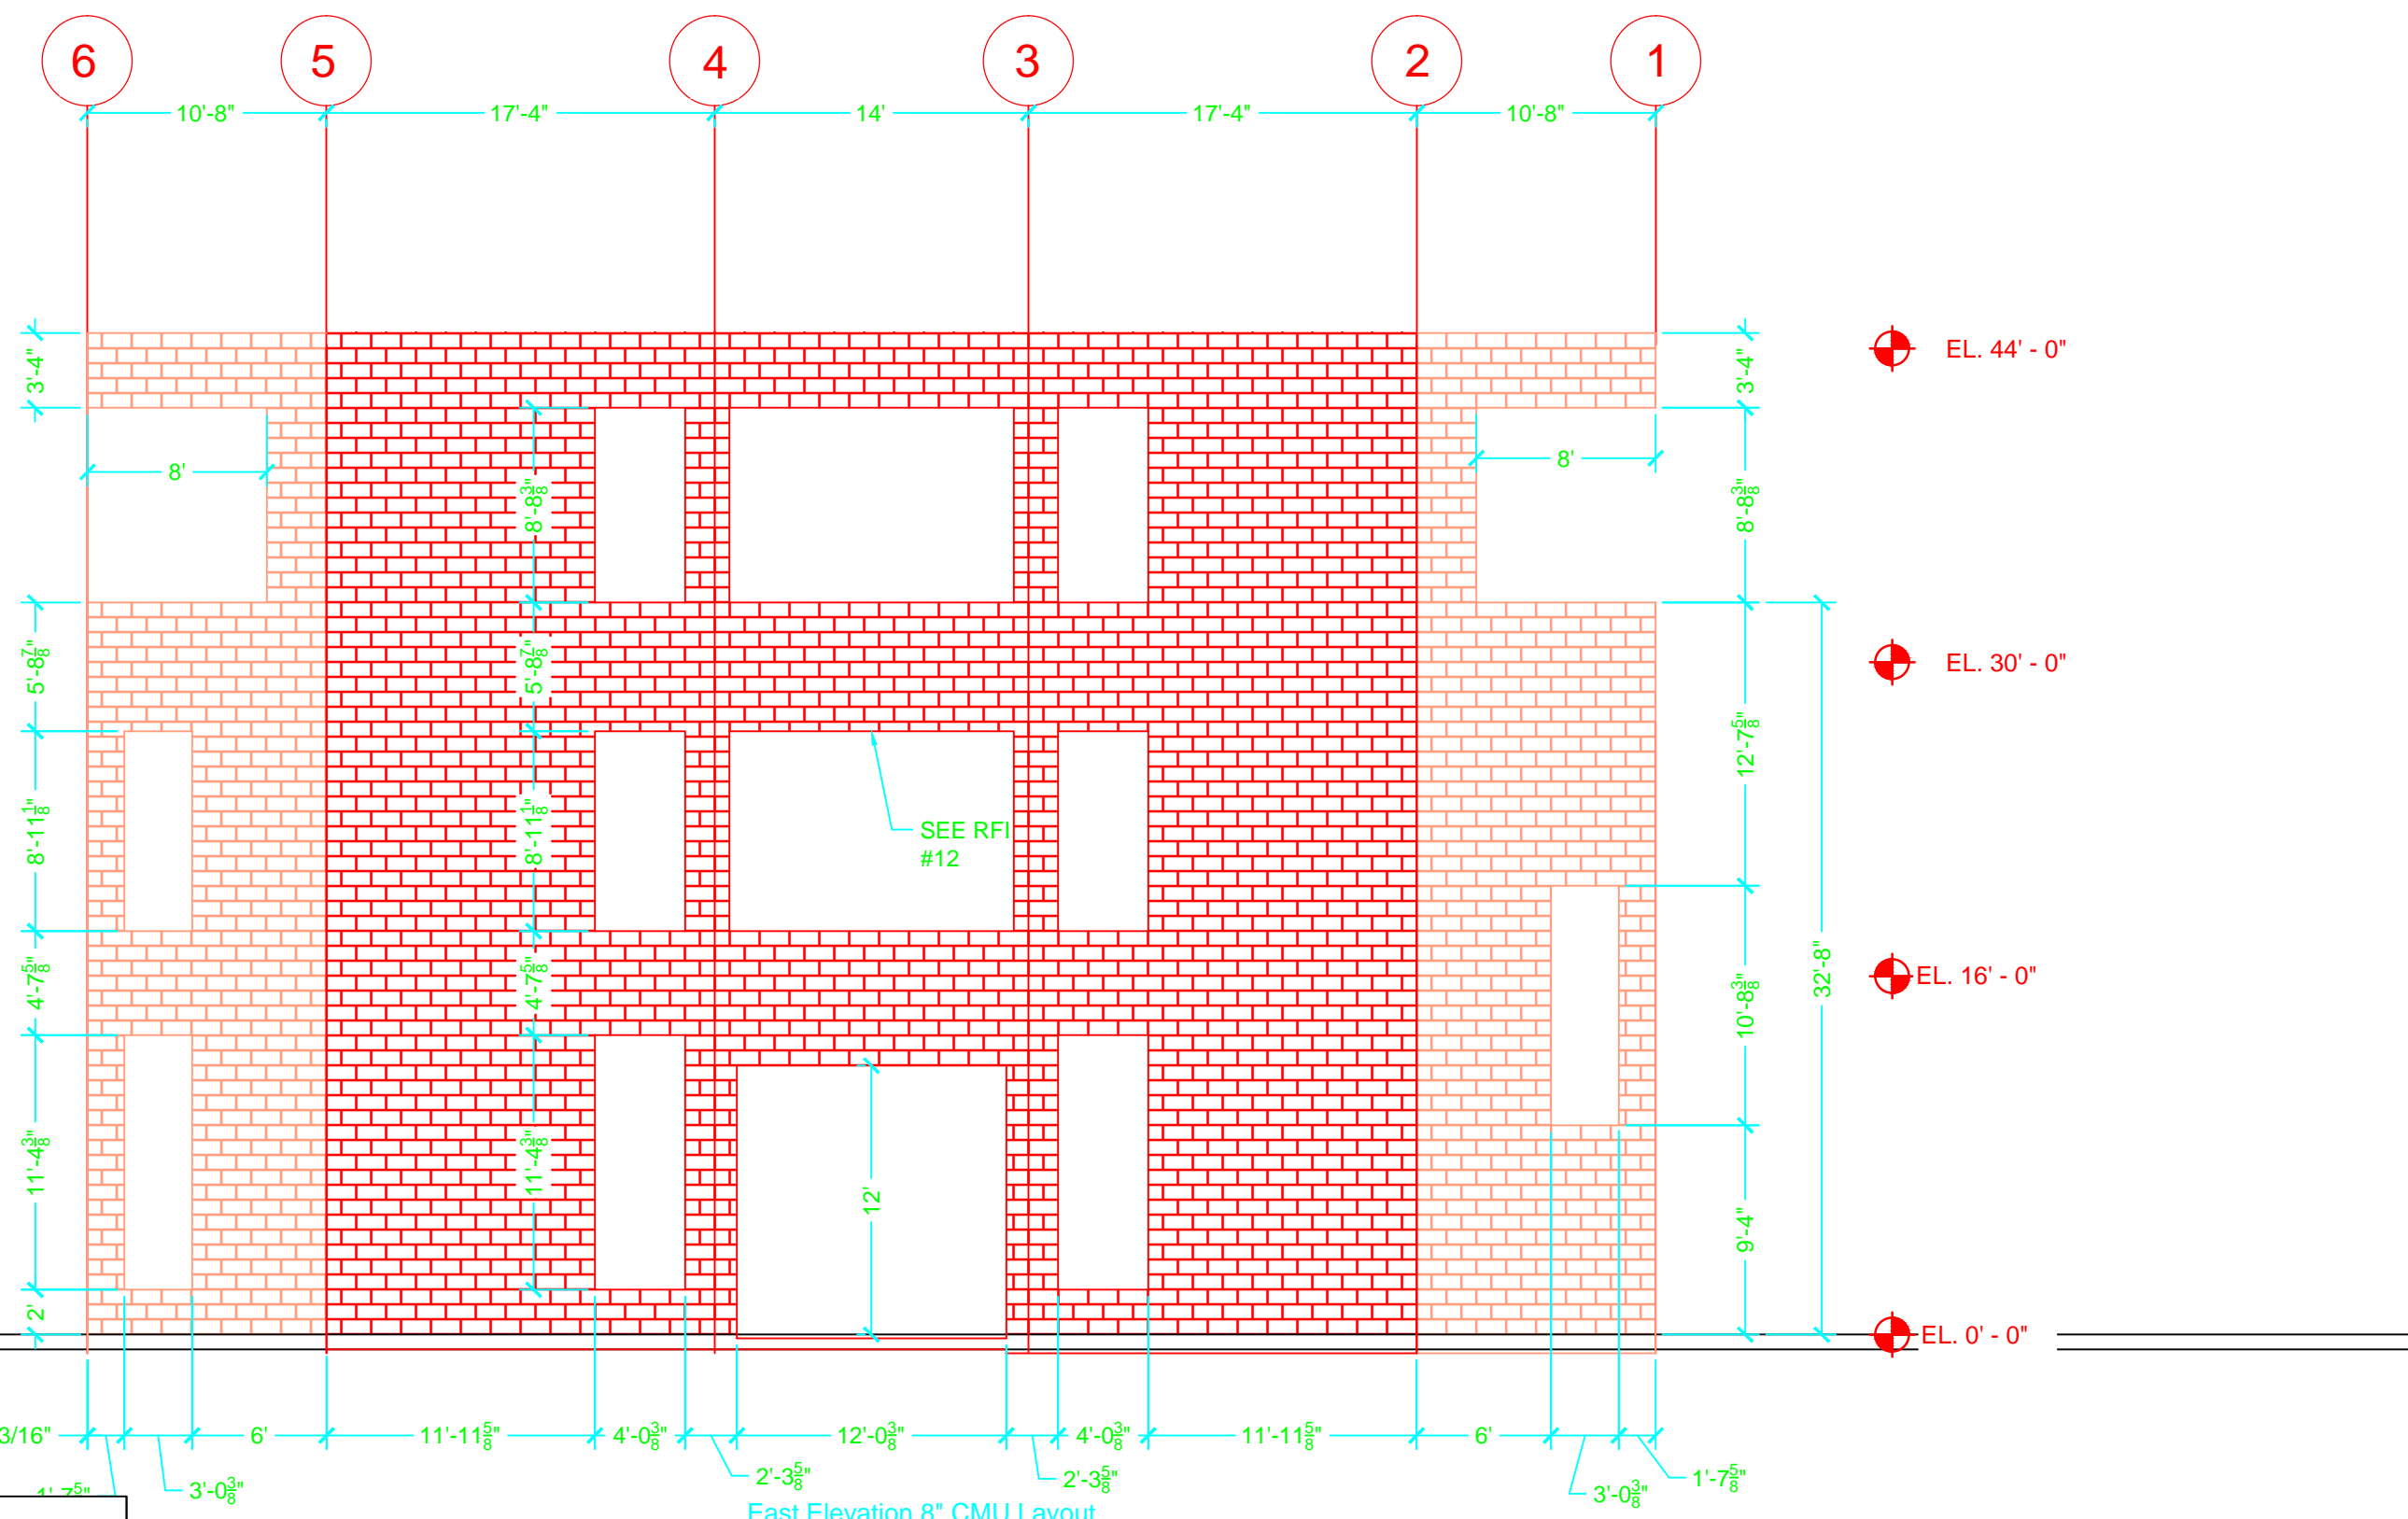

East Elevation 8" CMU Layout




WWW.JANDSMASONRY.COM  
 425-888-0200 WA  
 503-581-7650 OR

### EAST ELEVATION 8" CMU DIMENSIONS

DATE: 6-01-10	3A
SCALE: 1/8" = 1'-0"	



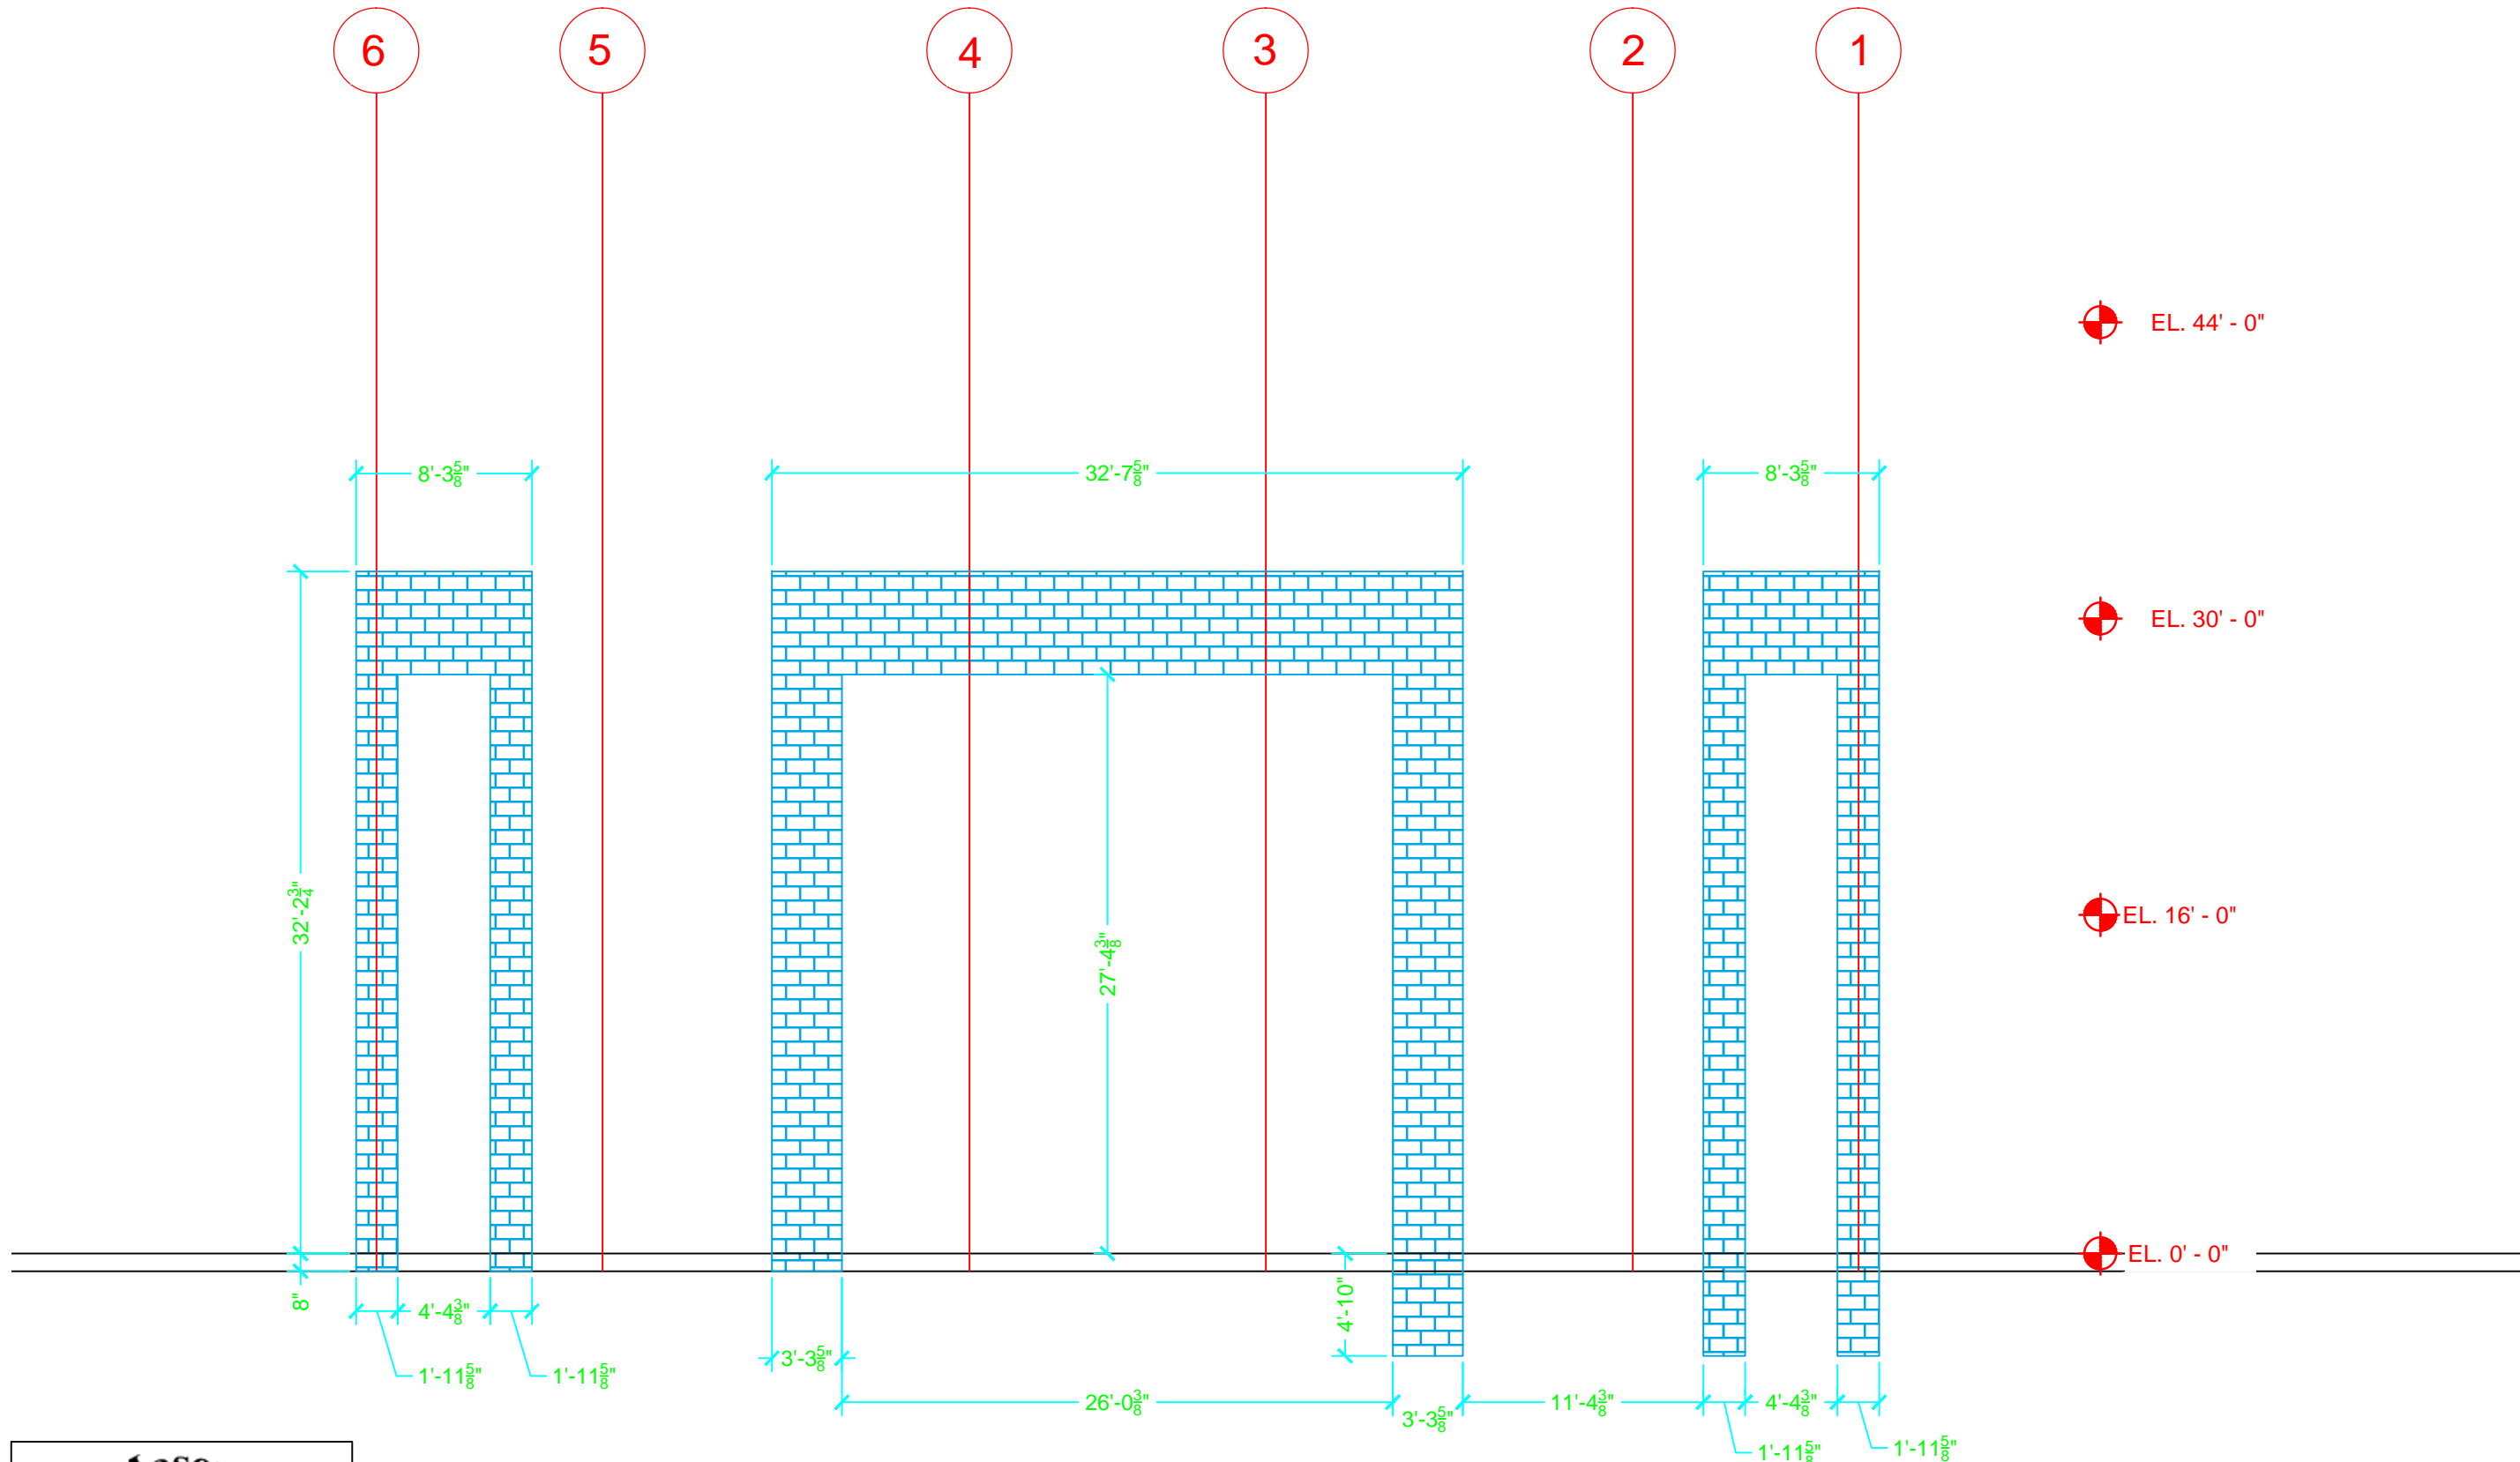


East Elevation 12" CMU Layout



WWW.JANDSMASONRY.COM  
 425-888-0200 WA  
 503-581-7650 OR

**EAST ELEVATION  
 12" CMU DIMENSIONS**

DATE: 6-01-10  
 SCALE: 1/8" = 1'-0"

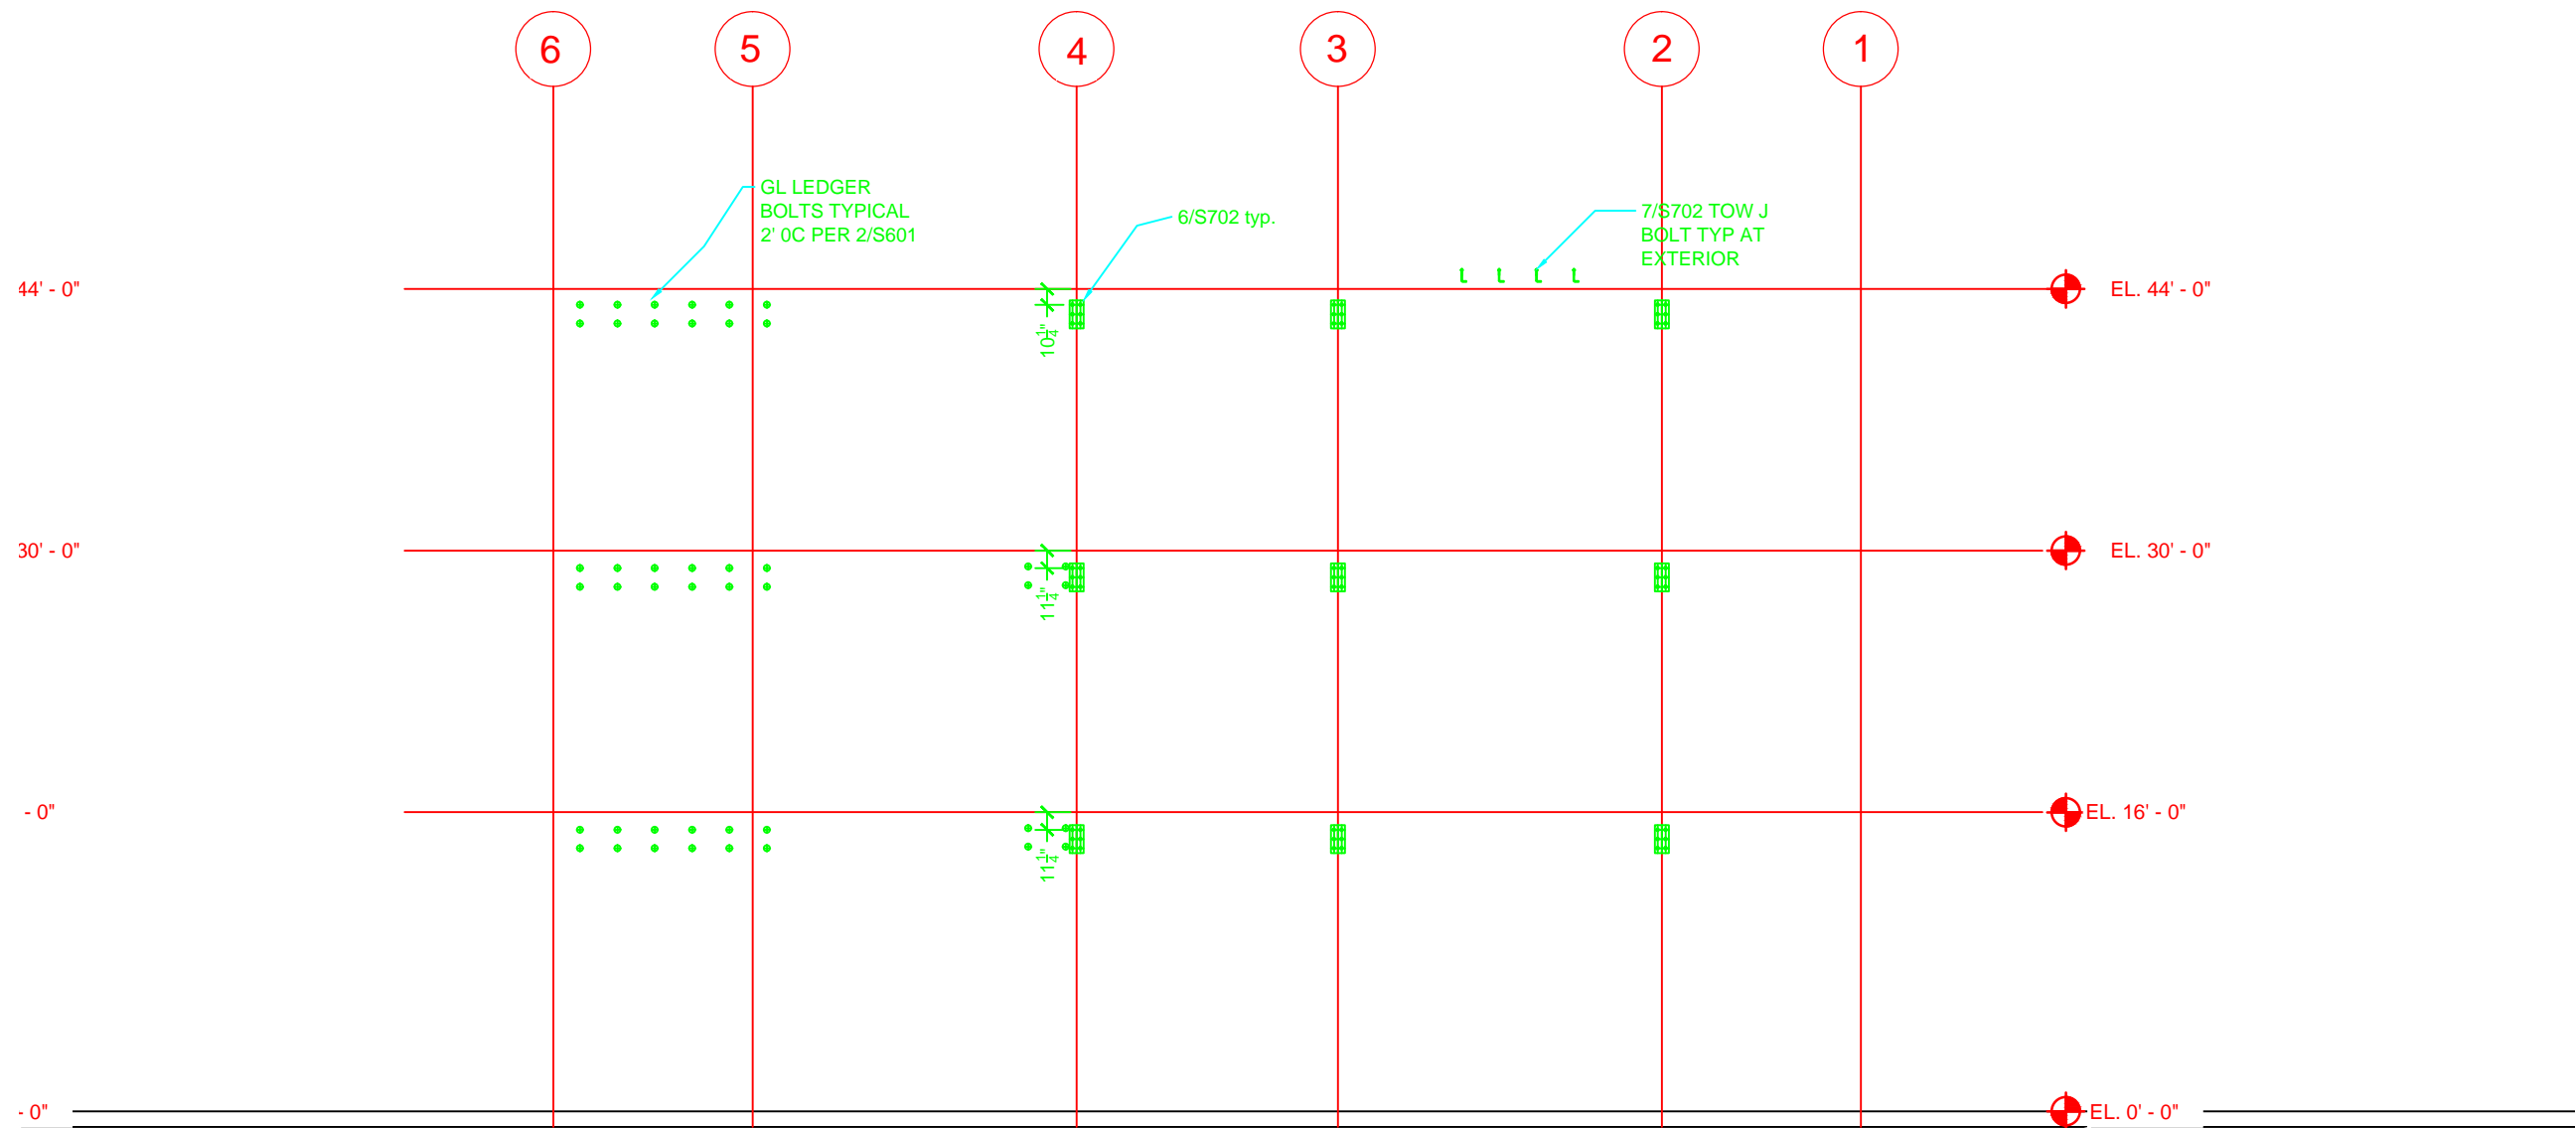


WWW.JANDSMASONRY.COM  
 425-888-0200 WA  
 503-581-7650 OR

**EAST ELEVATION  
 EMBED LAYOUT**

DATE: 6-01-10  
 SCALE: 1/8" = 1'-0"

**3C**

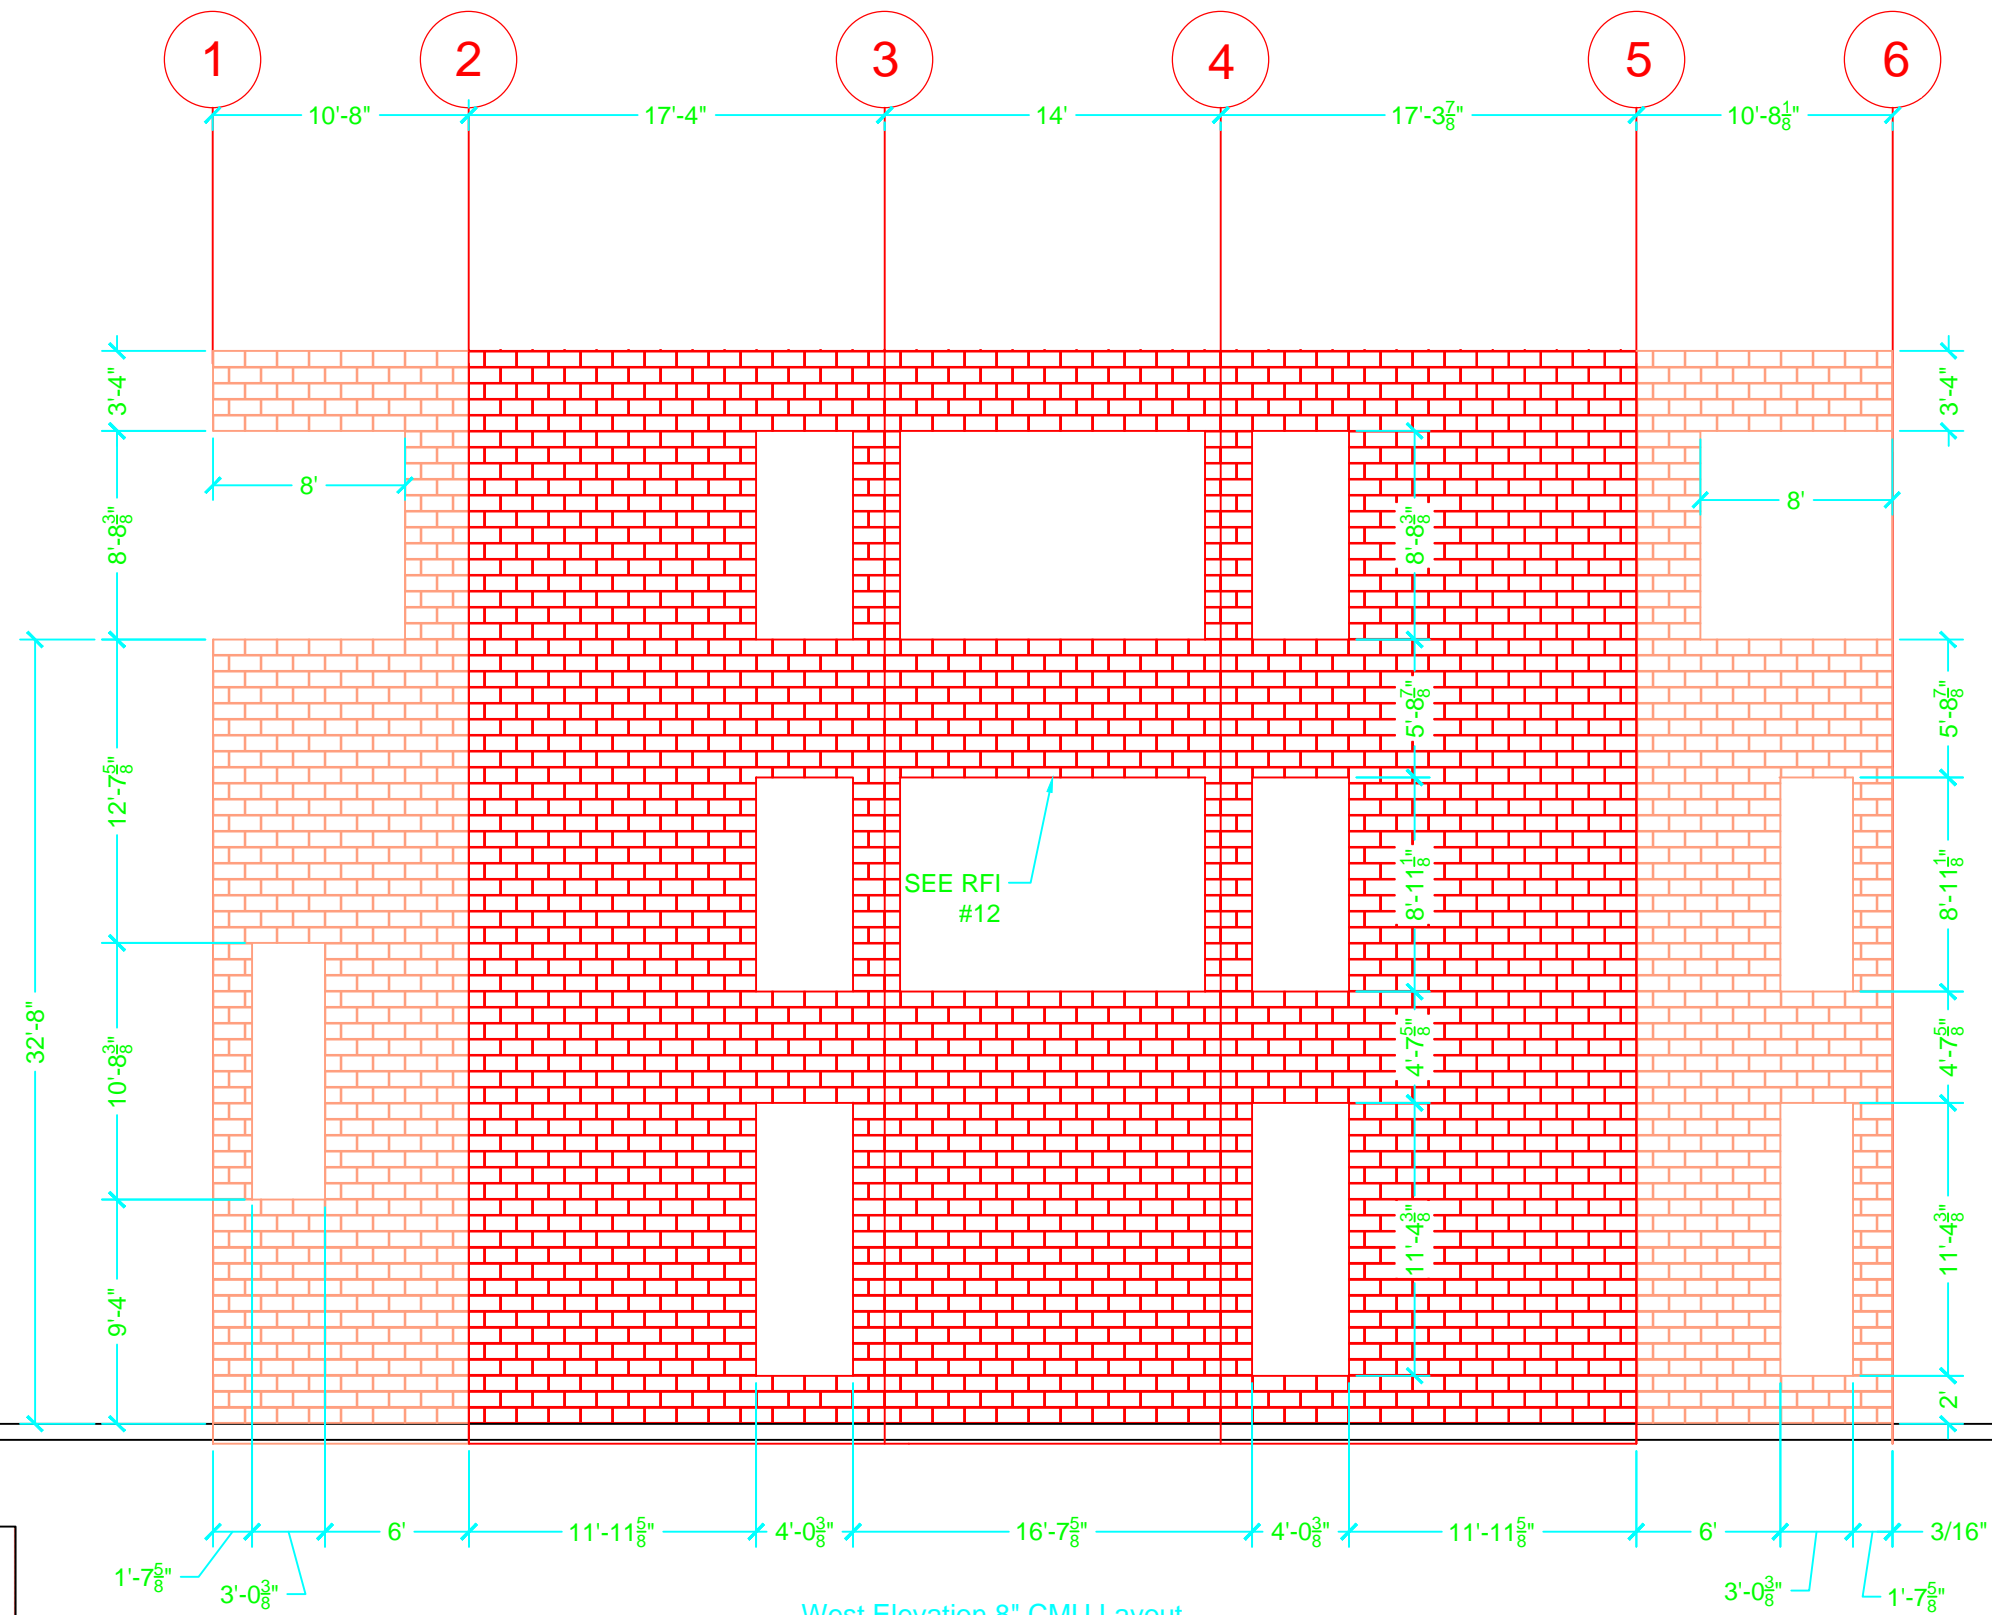


West Elevation 8" CMU Layout



WWW.JANDSMASONRY.COM  
 425-888-0200 WA  
 503-581-7650 OR

**WEST ELEVATION  
 8" CMU DIMENSIONS**

DATE: 6-01-10	<b>4A</b>
SCALE: 1/8" = 1'-0"	

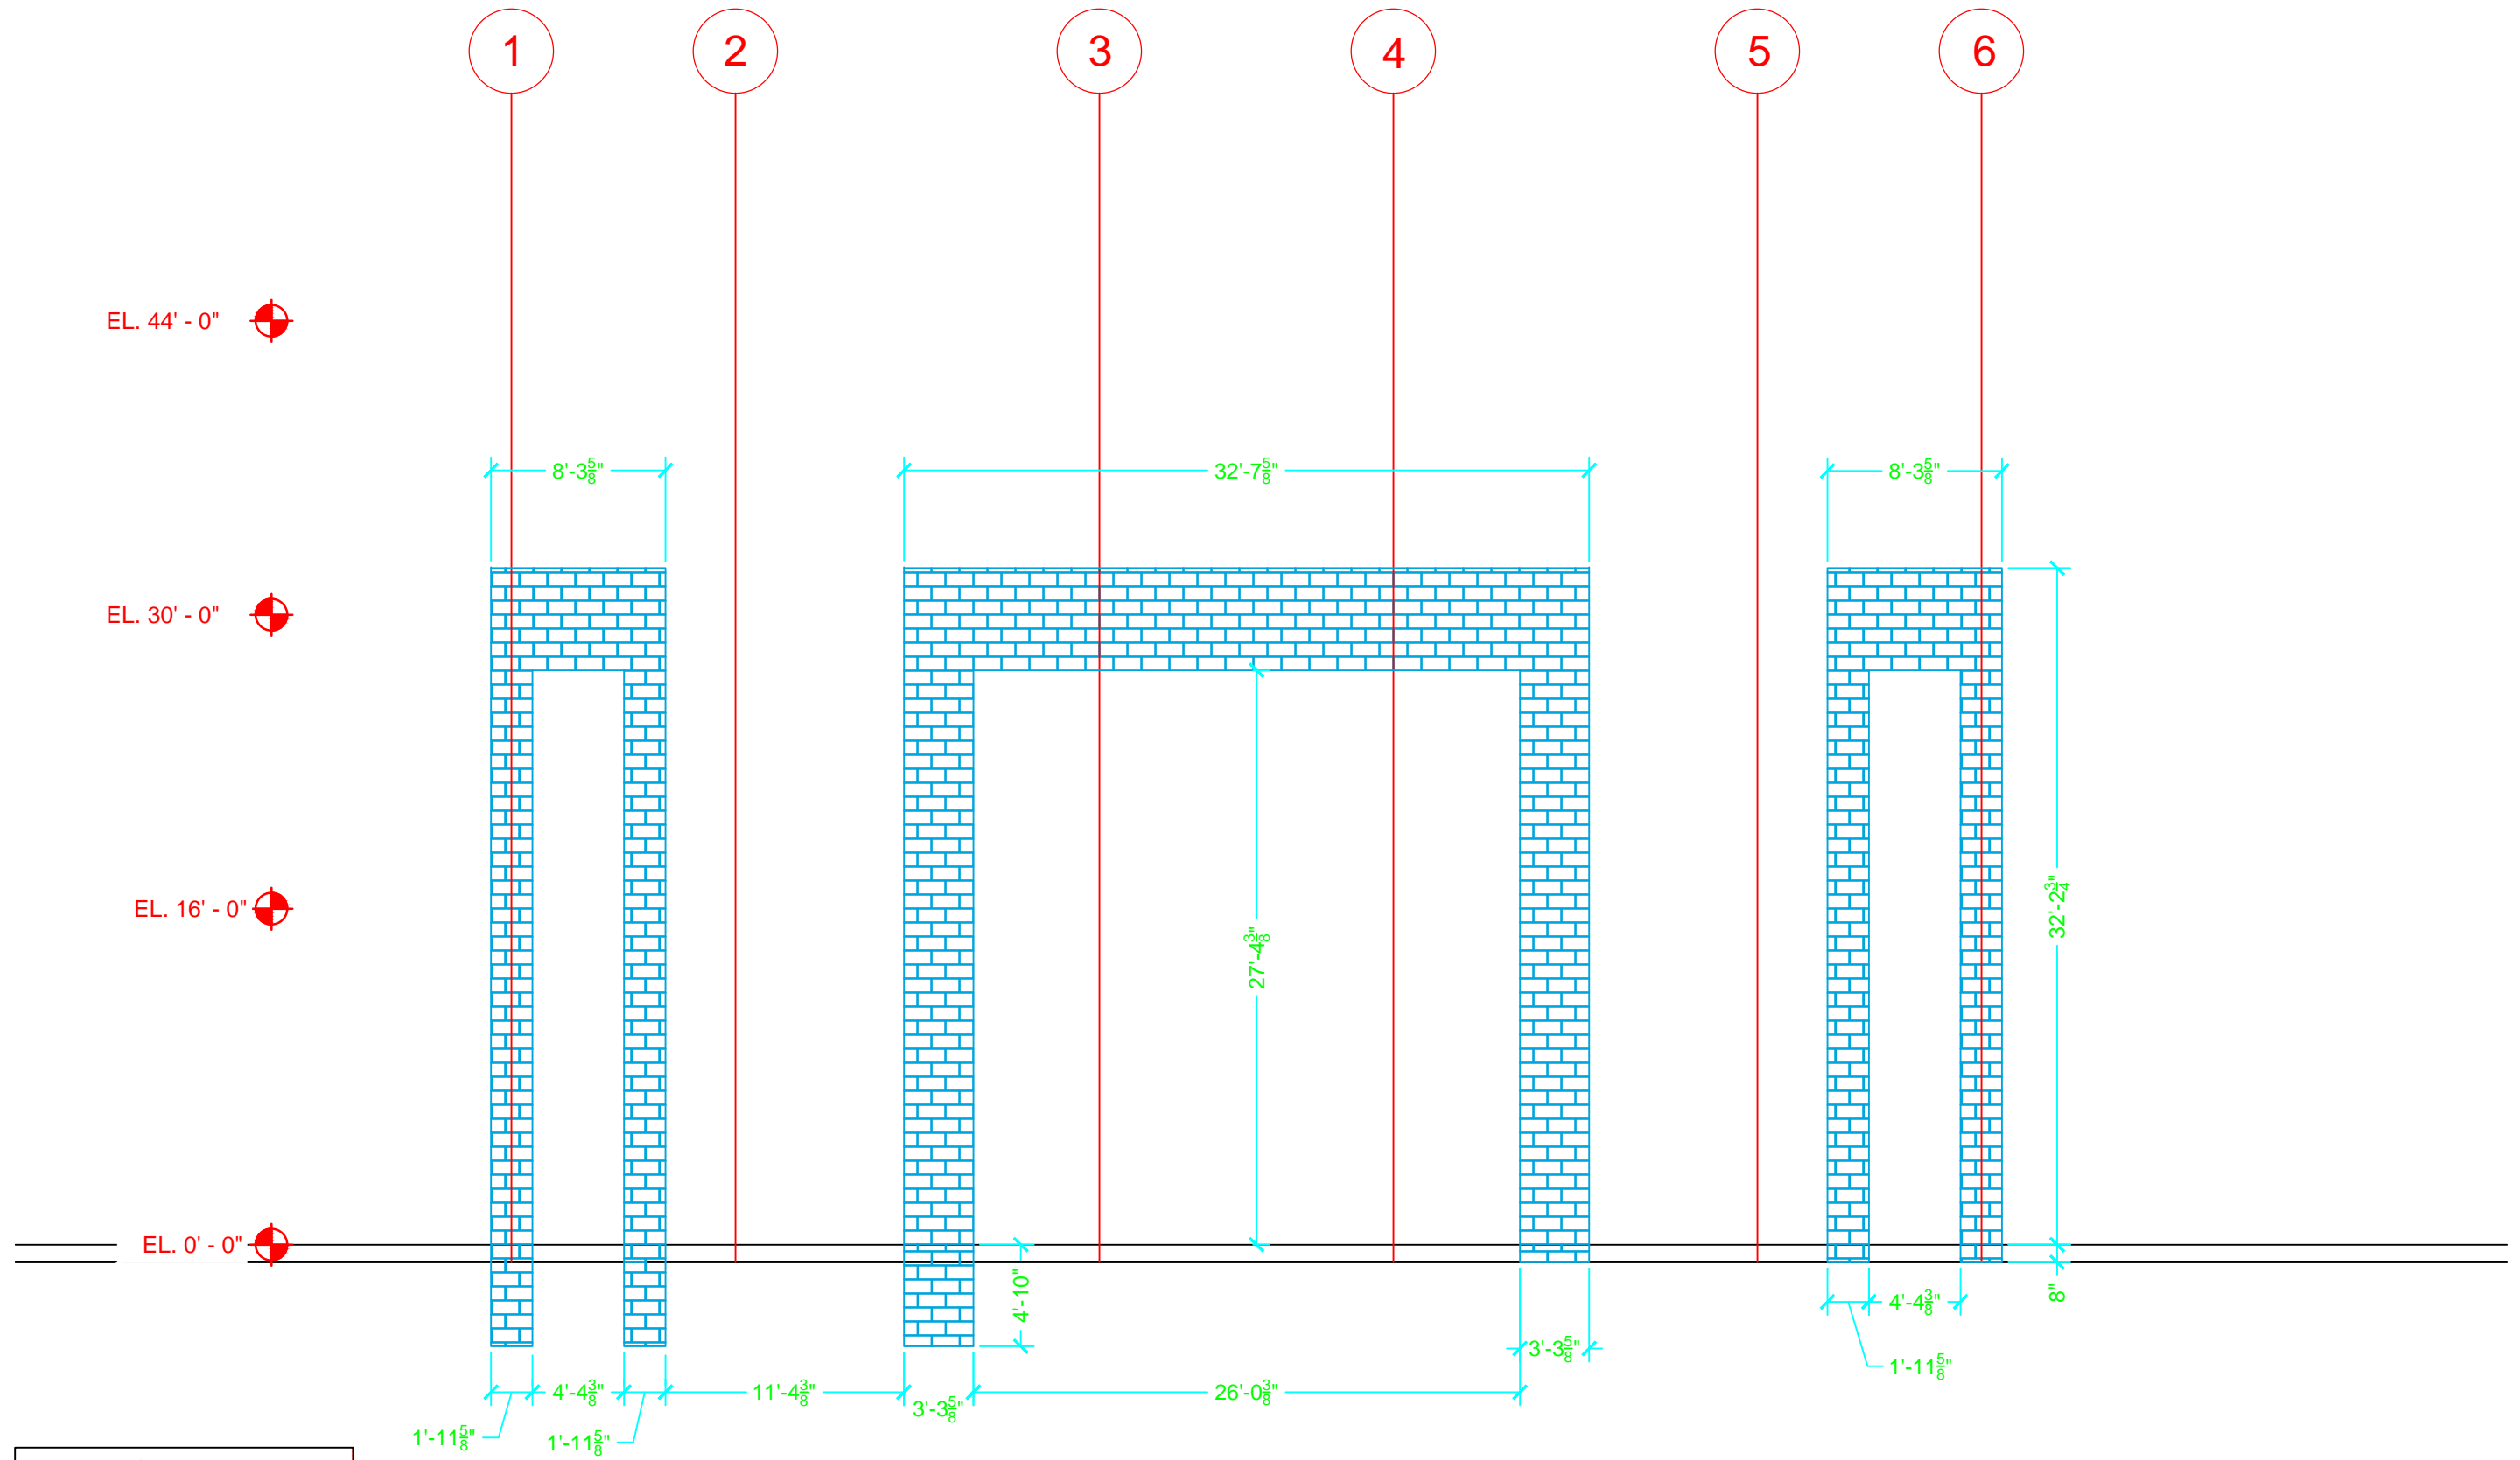


West Elevation 12" CMU Layout



WWW.JANDSMASONRY.COM  
 425-888-0200 WA  
 503-581-7650 OR

**WEST ELEVATION  
 12" CMU DIMENSIONS**


DATE: 6-01-10	<b>4B</b>
SCALE: 1/8" = 1'-0"	

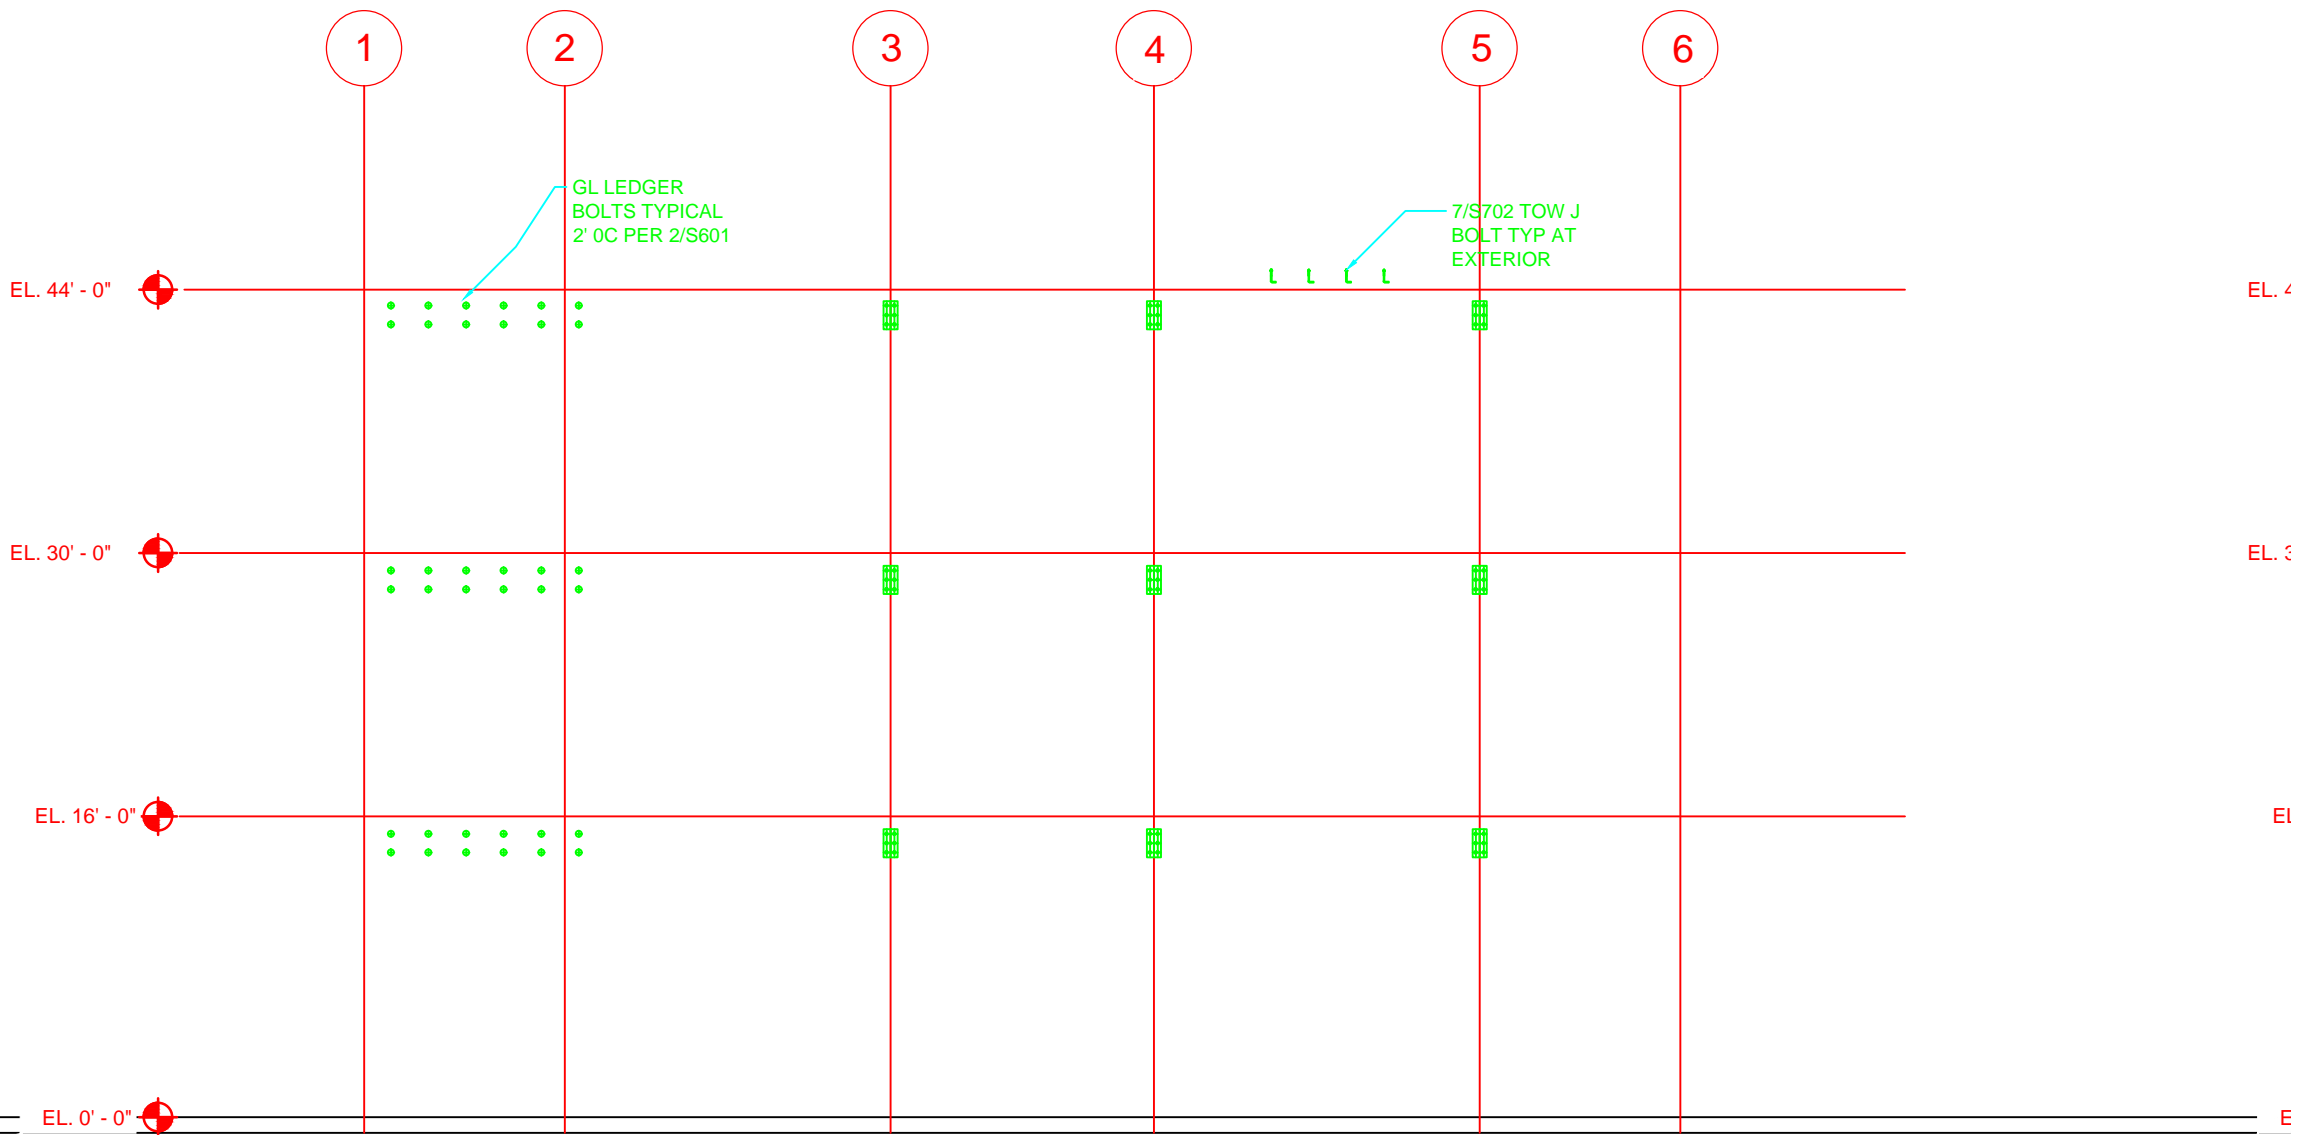

WWW.JANDSMASONRY.COM  
 425-888-0200 WA  
 503-581-7650 OR

**WEST ELEVATION  
 EMBED LAYOUT**

DATE: 6-01-10  
 SCALE: 1/8" = 1'-0"

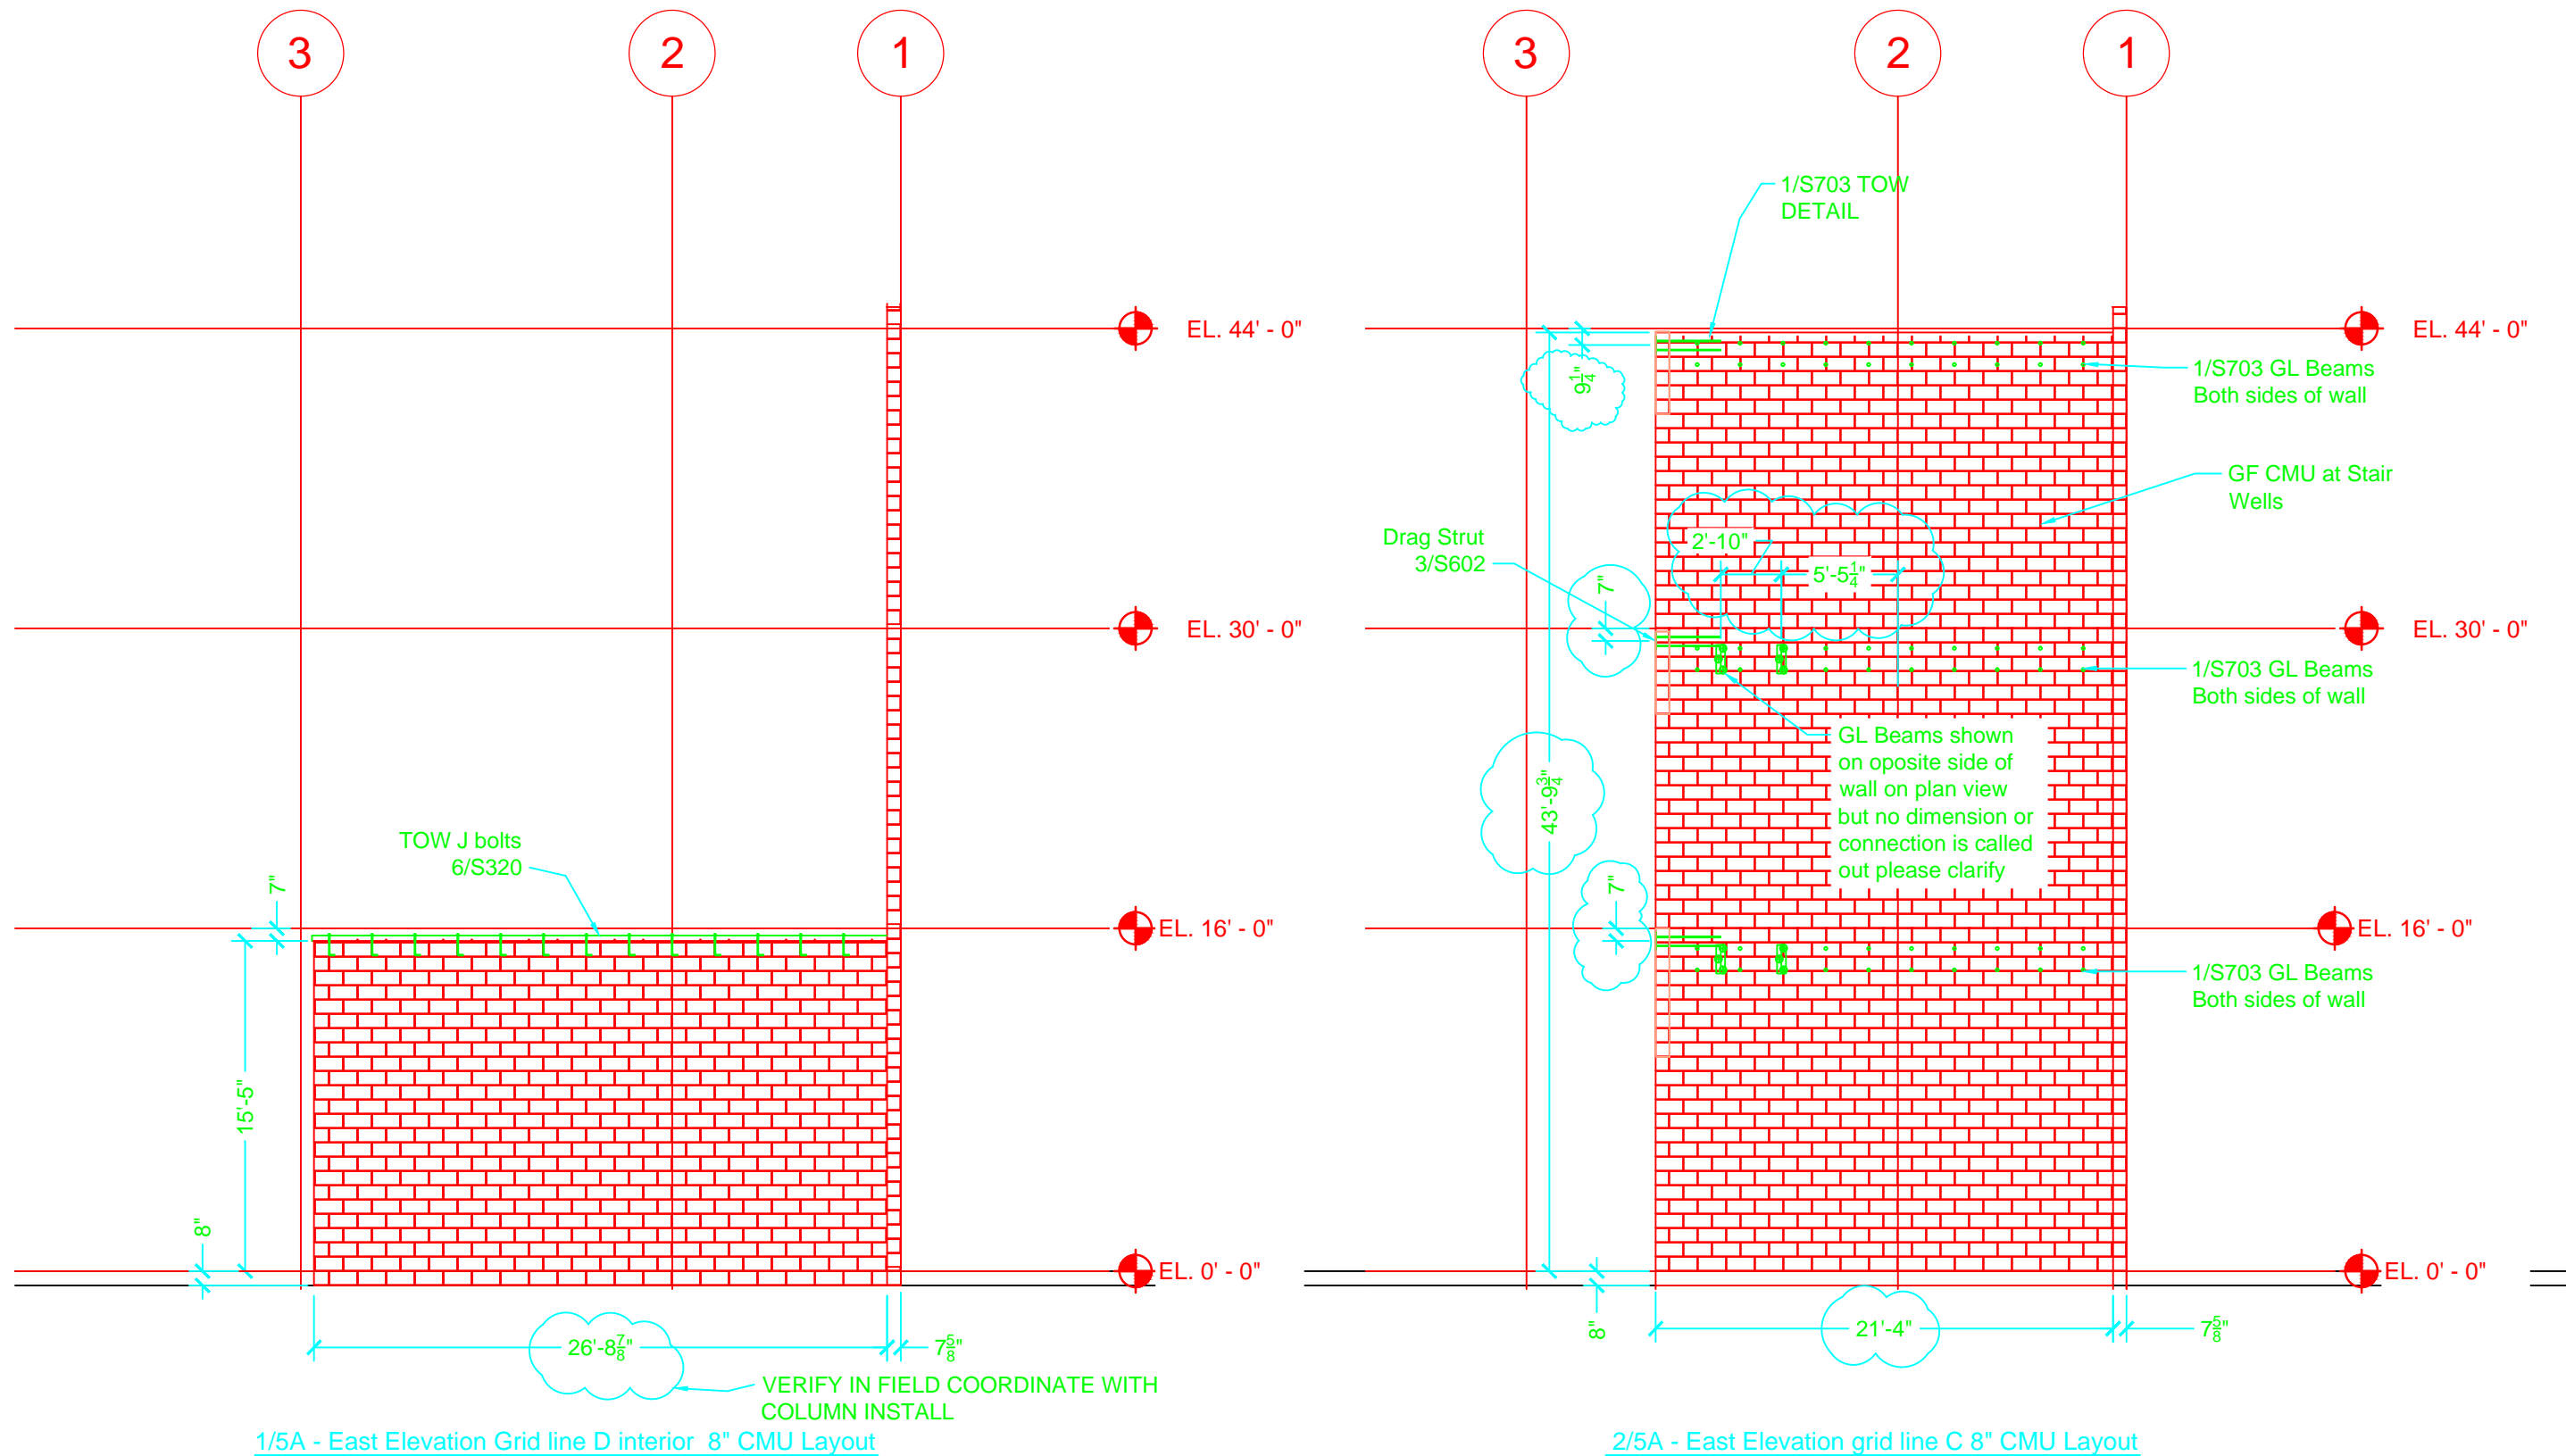


WWW.JANDSMASONRY.COM  
425-888-0200 WA  
503-581-7650 OR

**Interior  
8" CMU DIMENSIONS**

DATE: 6-01-10  
SCALE: 1/8" = 1'-0"

**5A**

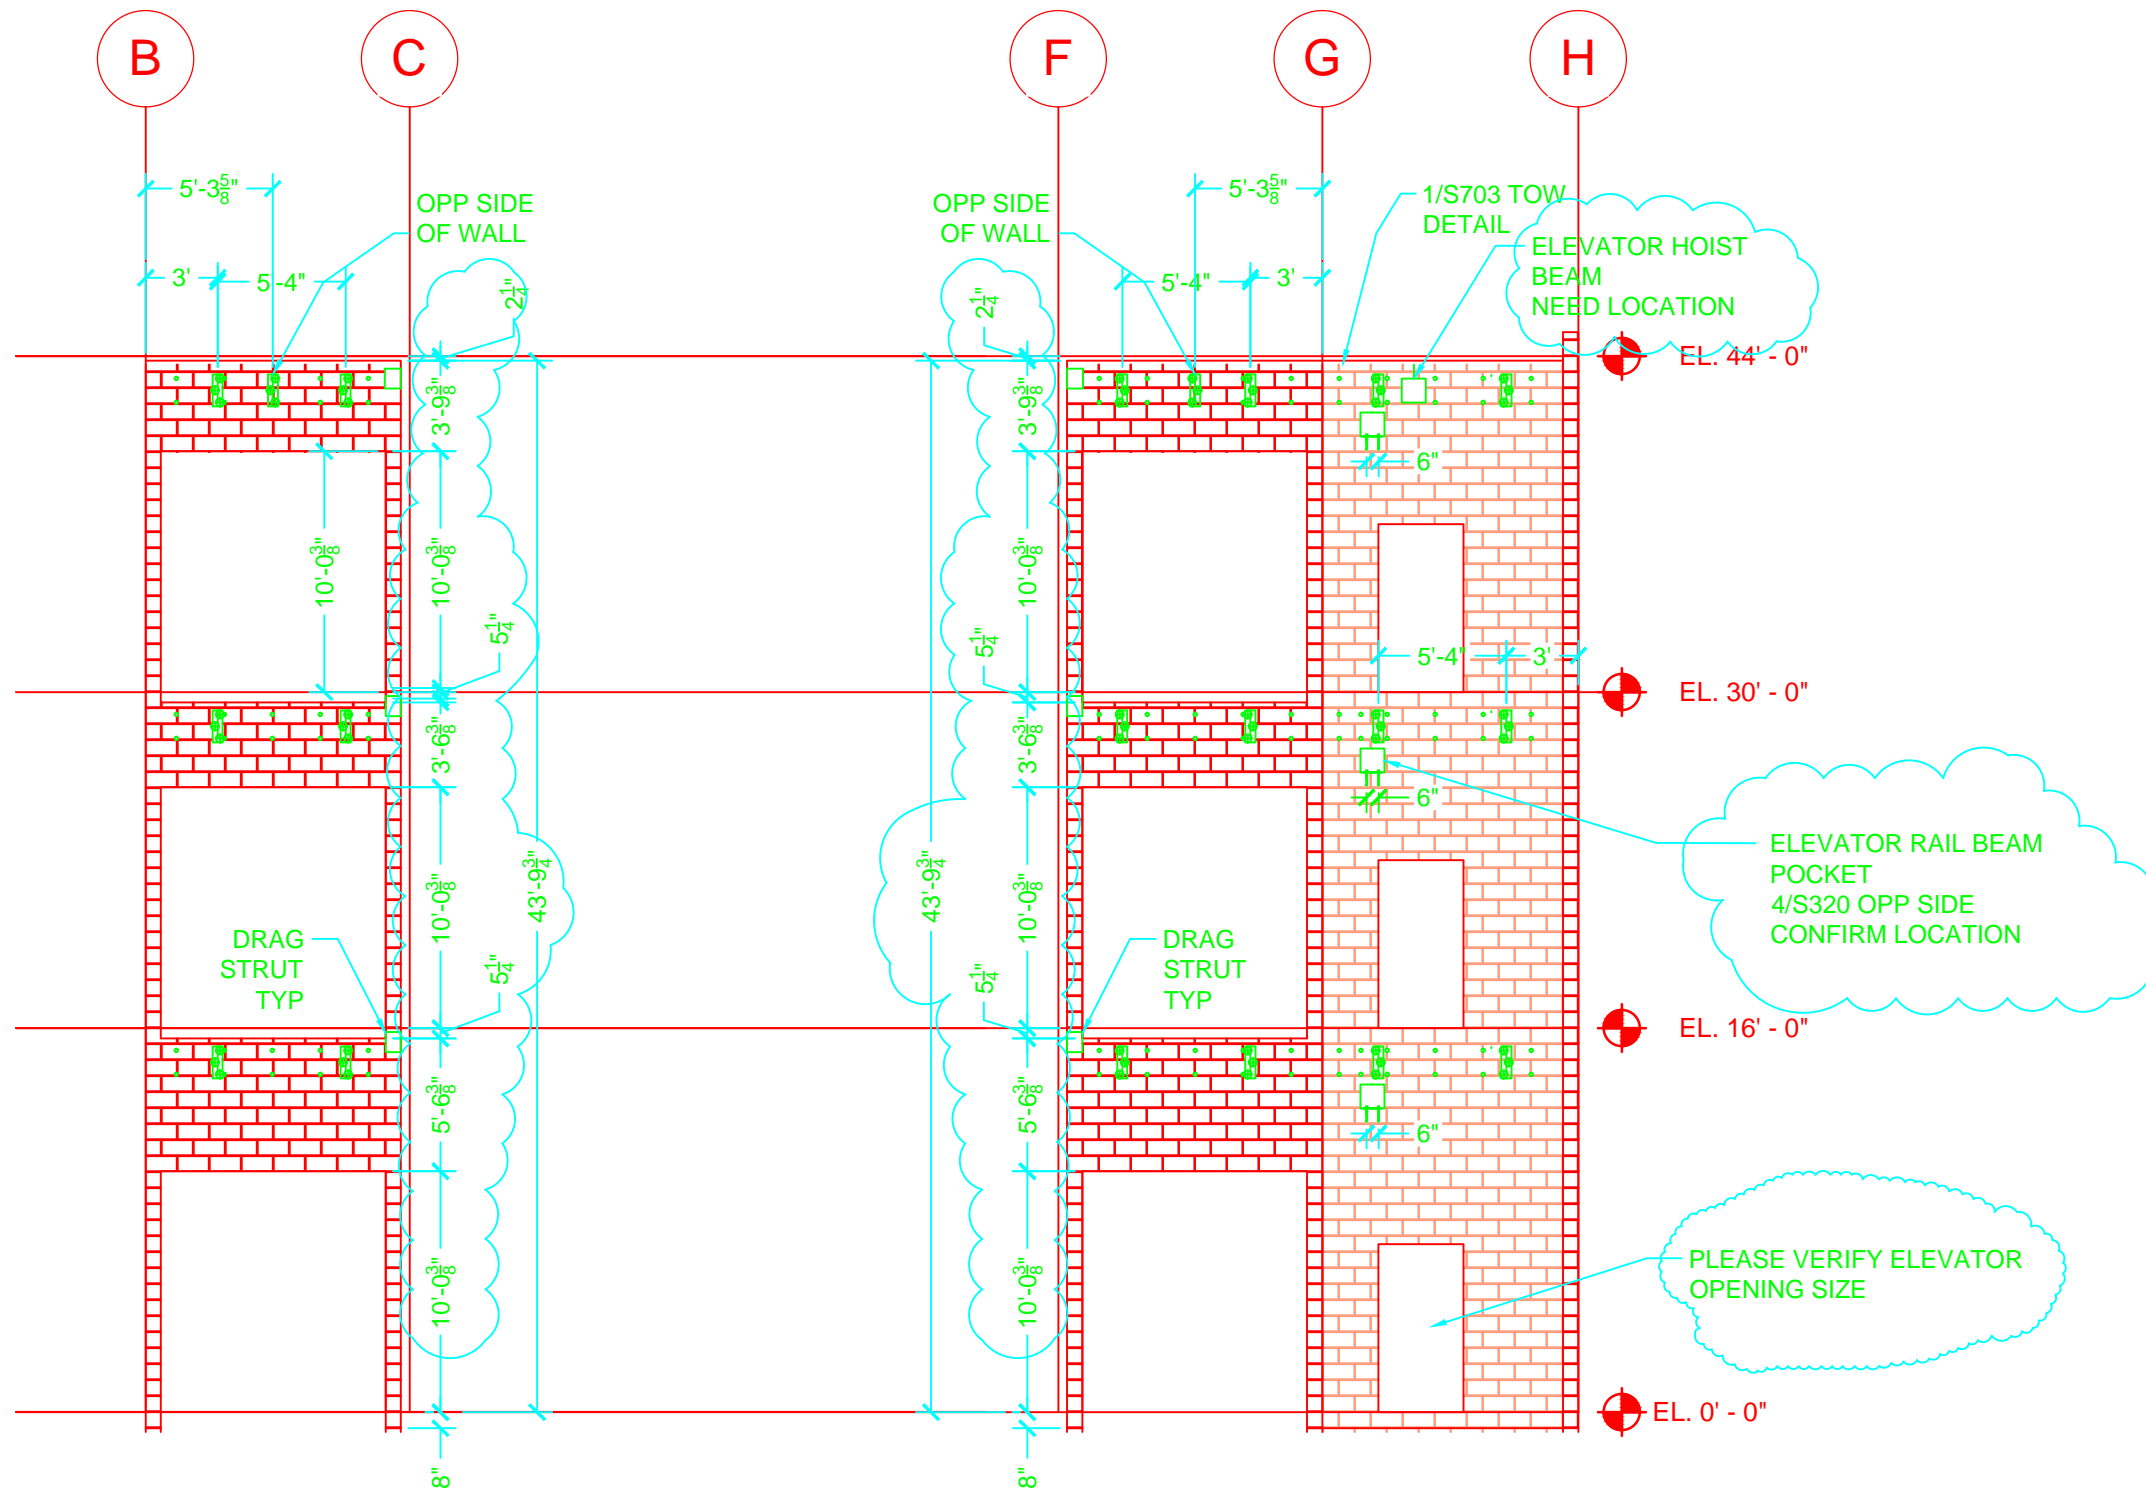

2/5B - 8" CMU INTERIOR ELEVATION LAYOUT

1/5B 8" CMU INTERIOR ELEVATION LAYOUT





WWW.JANDSMASONRY.COM  
 425-888-0200 WA  
 503-581-7650 OR

Interior  
 8" CMU DIMENSIONS

DATE: 6-01-10

SCALE: 1/8" = 1'-0"

5B

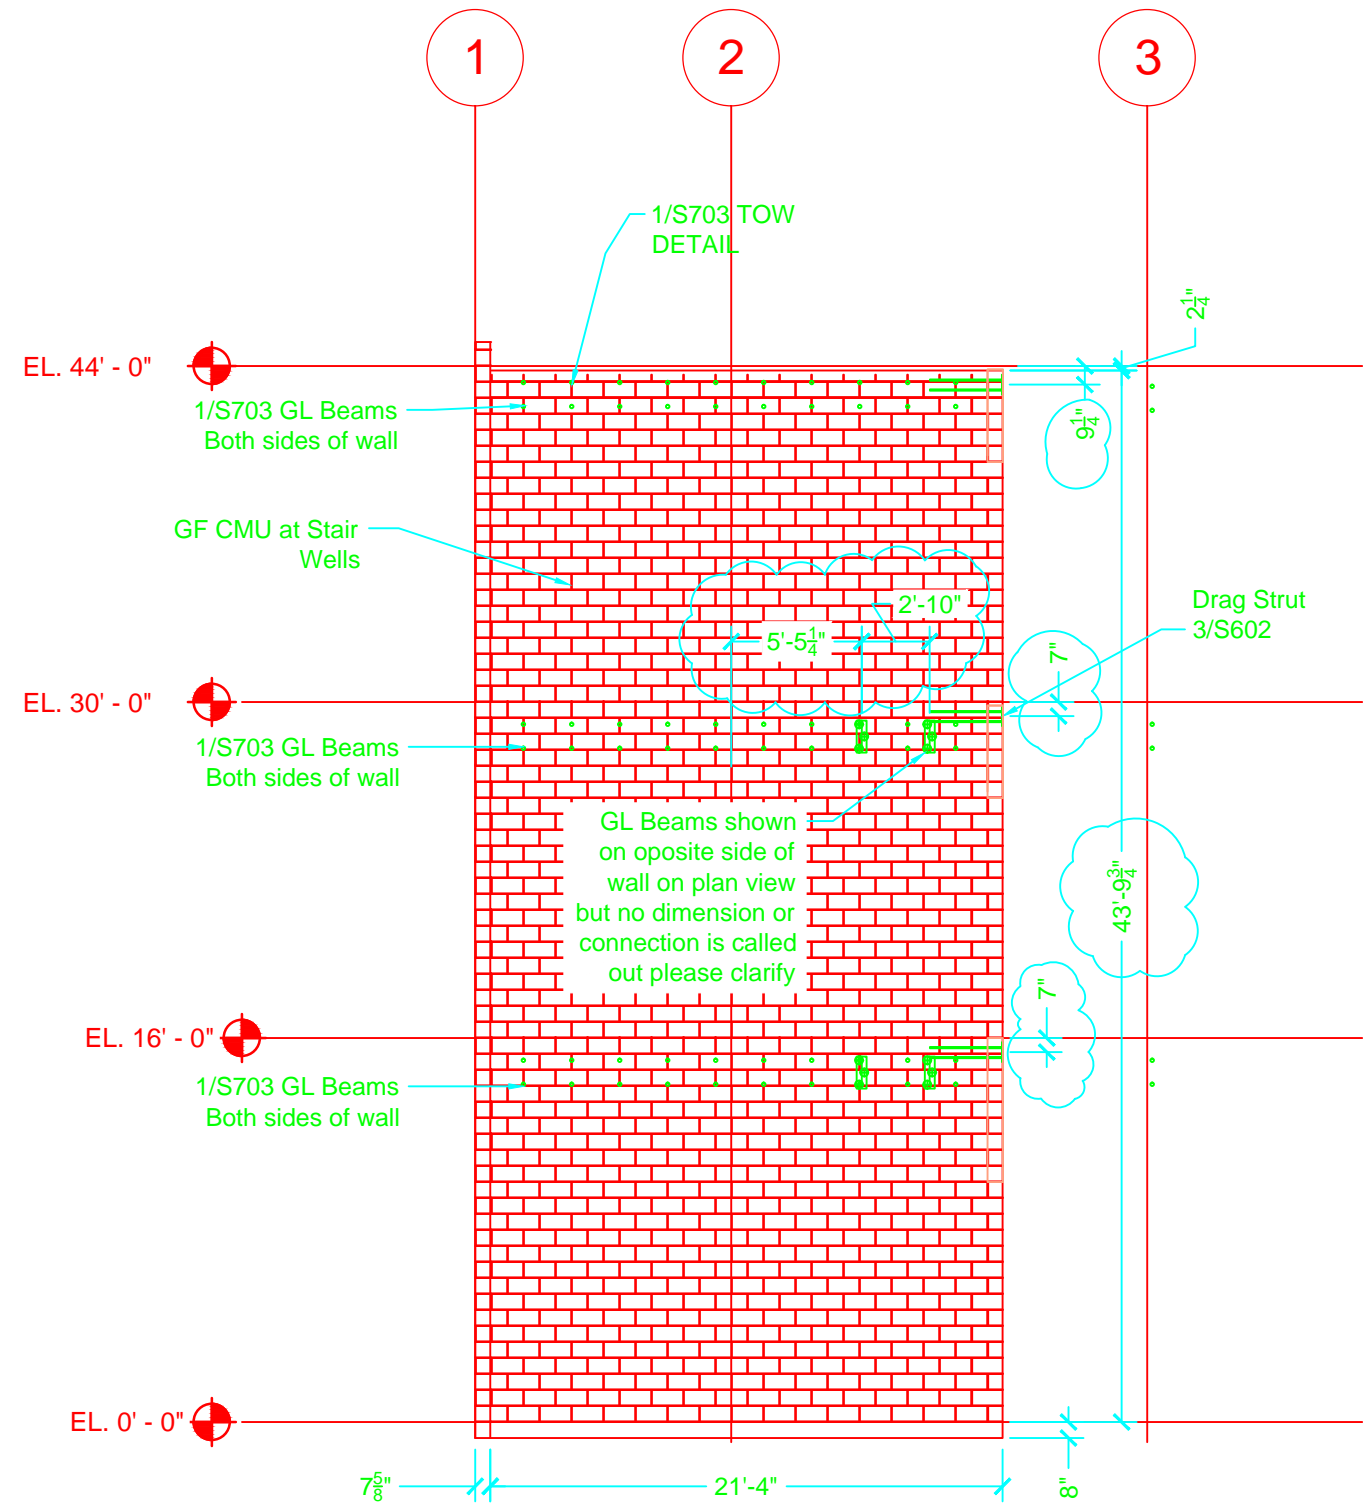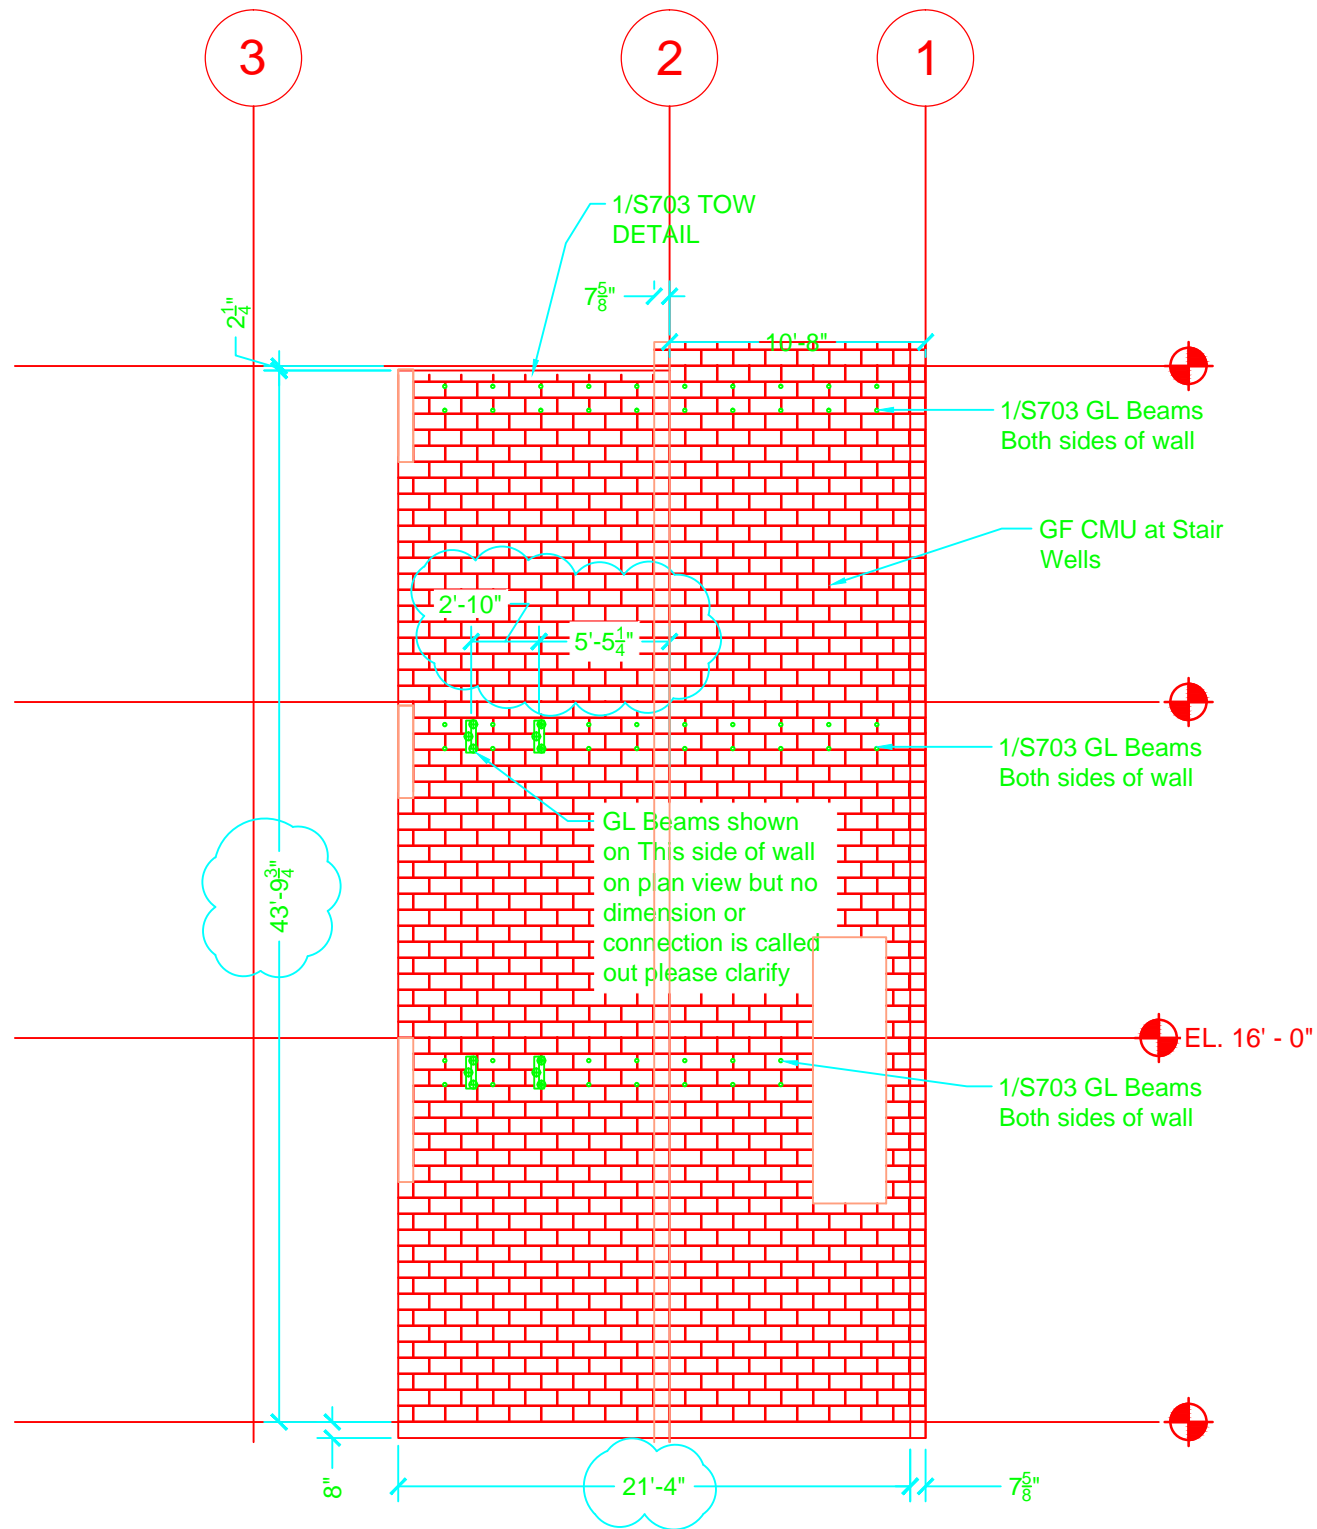

East Elevation grid line B 8" CMU Layout

1/5C - West Elevation grid line F 8" CMU Layout




WWW.JANDSMASONRY.COM  
 425-888-0200 WA  
 503-581-7650 OR

## Interior 8" CMU DIMENSIONS

DATE: 6-01-10

SCALE: 1/8" = 1'-0"



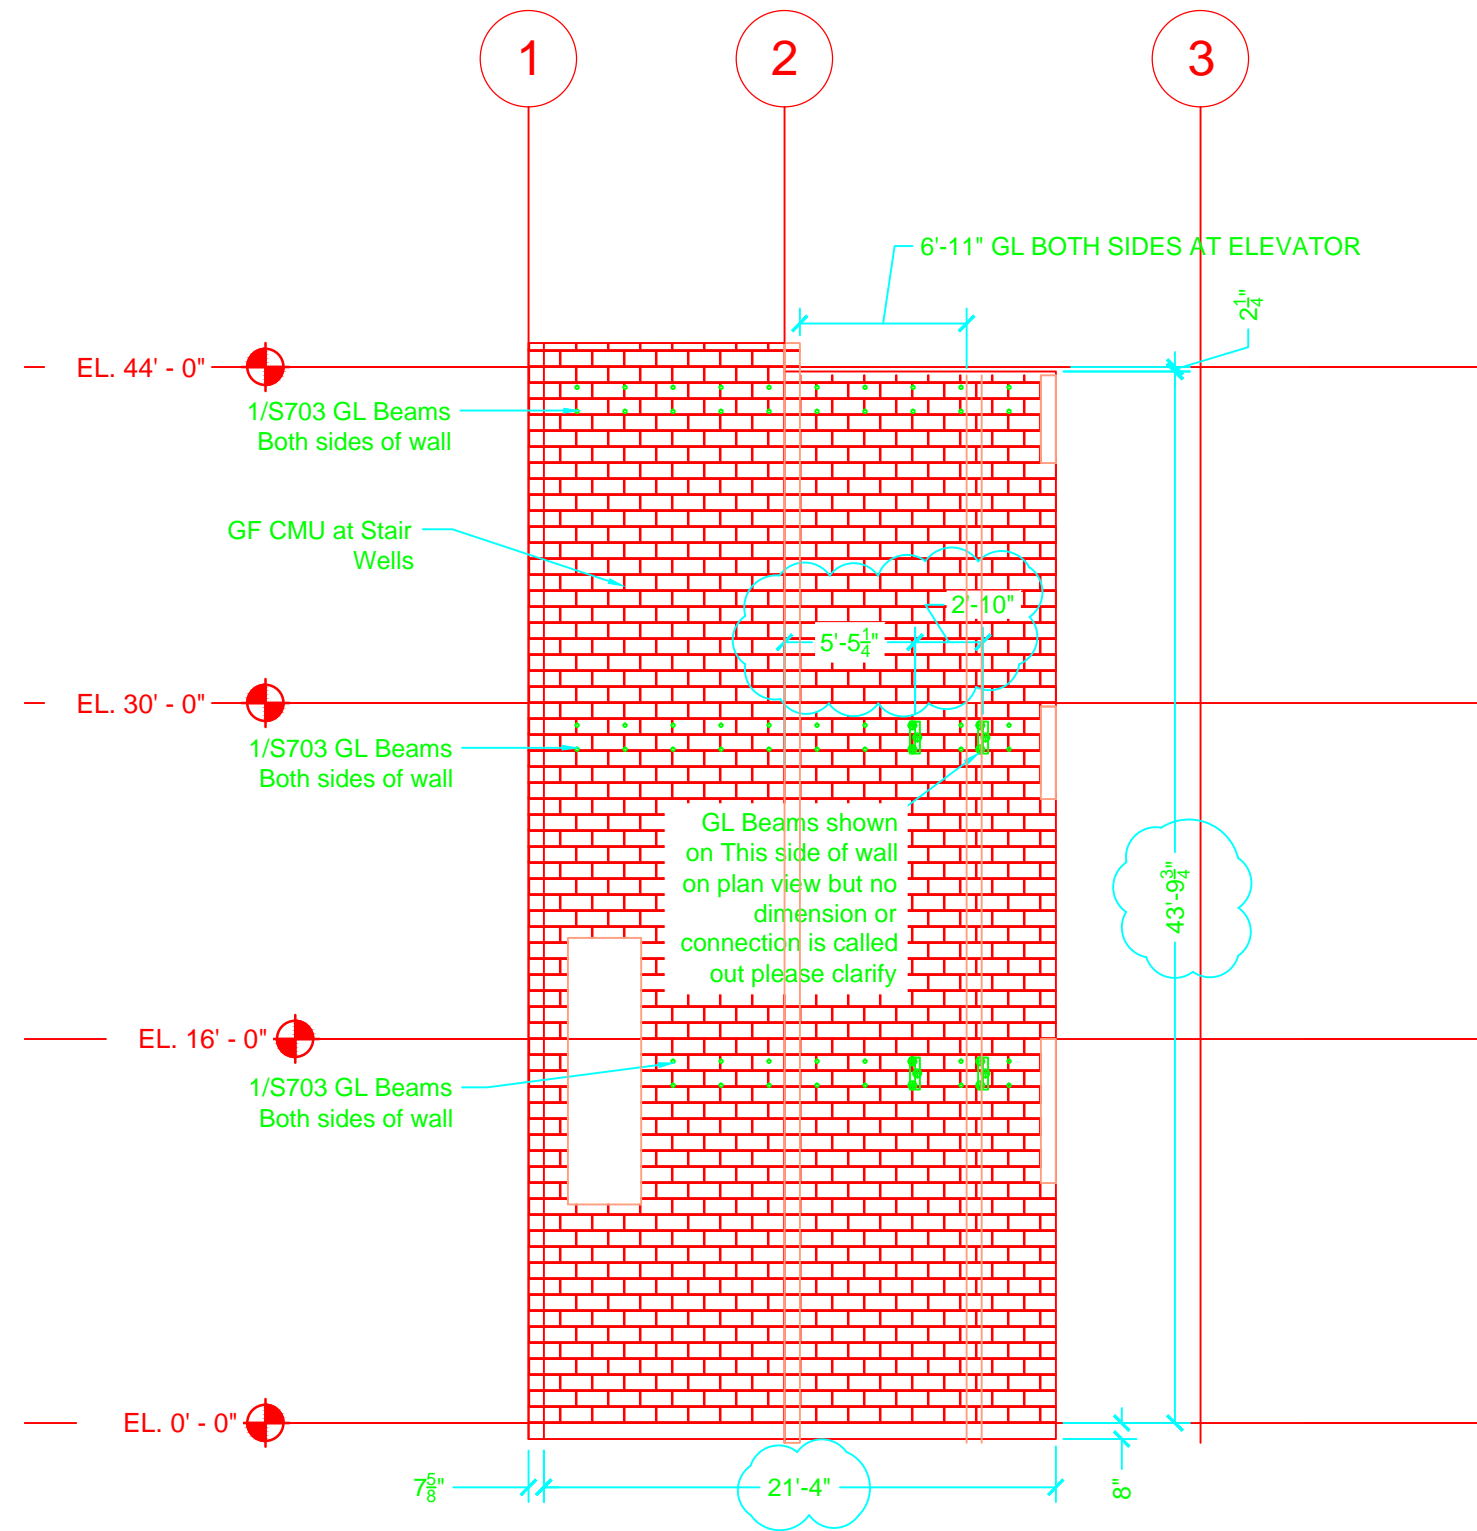

West Elevation grid line G 8" CMU Layout



WWW.JANDSMASONRY.COM  
 425-888-0200 WA  
 503-581-7650 OR

Interior  
 8" CMU DIMENSIONS

DATE: 6-01-10

SCALE: 1/8" = 1'-0"

5D